

**SURVEY & MONUMENTATION**


**JAN 23 2001**

**LAND CORNER RECORDATION CERTIFICATE**

Filing Requirement of Act 74, Mich. P.A. 1970

For corners in: **SECTION** Located In: Corner Code #  
Mason County

1. Public Land Survey T 17N R 17W M-6  
T 17N R 16W A-6 ✓  
T R  
T R
- in Section S T R  
3. Miscellaneous S T R  
Property in Sec. S T R
- 4 Lot No. Recorded Plat  
5. Private Claims

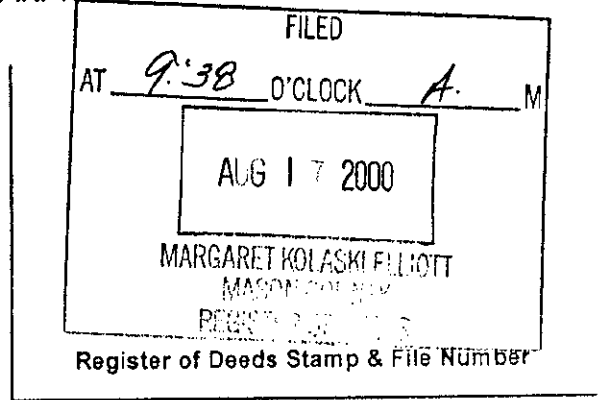

	A	B	C	D	E	F	G	H	I	J	K	L	M
1													
2	6	5	4	3	2	1							
3													
4	7	8	9	10	11	12							
5													
6	18	17	16	15	14	13							
7													
8	19	20	21	22	23	24							
9													
10	30	29	28	27	26	25							
11													
12	31	32	33	34	35	36							
13													

I, Kenneth L. Ross, in a field survey on May 4, 2000, Do hereby certify that under requirements of P.A. 74, Michigan P.A. of 1970, the corner points mentioned in lines 1 and 2 above were in conformance with regulations and rules therefore as required in the current manual of survey instructions of the United States Department of the Interior, Bureau of Land Management or by a decree of a Court of Law and/or that the corner points mentioned in lines 3, 4 and 5 above were in conformance with the rules of the Michigan Board of Land Surveyors or by a Decree of a Court of Law; established, re-established, monumented, re-monumented, recovered, found as expressed below:

¼ corner common to sections 18 of T.17N., R16W., and section 13 of T17N, R17W

**A. Description of original monument and accessories and/or subsequent restoration:**

GLO Mullett & Brookfield 1837 Set Post Beech 12 N59W 47lks. (31.02') (#1)  
Hem. 8 S71W 30lks. (19.80') (#2)

Ross PLS 17634, unrecorded survey & Act 74, L.1, P259, 8-21-73  
Fen. Post W/1/2" rebar in center  
Fence to East in cen. N-S rd.  
PP west 37.70' (#3)

Ross PLS 17634 Unrecorded survey May, 1996  
"iron in monument box"  
No witnesses.

R.O Towns May, 1905, B2-P119  
"located this 1/4 post by stake and planted iron" No. witnesses.

Bonney PLS 12016  
Recorded survey 7-20-92 & Act 74  
Fd. 1/2" rerod  
PP S50E 34.40' (#4)  
14" Apple East 59.70' (#5)  
12" Poplar S56W 35.55' (#6)

R.O. Towns, June 1905, B3-P156  
Same as above.

**B. Description of corner evidence found and/or method applied in restoring or reestablishing corner:**

I found a ½" ir inside a metal fence post in a monument box. I left these items intact and set a 5/8" x 24" iron rod over the top of the ½" ir. I placed an aluminum cap stamped "Mason County Monument" on the 5/8" iron rod.

Condition of witnesses: 1,2,4, and 5 are gone. 3 and 6 are in good condition.


I found nothing to dispute the location of this corner.

**C. Description of monument for corner and accessories established to perpetuate locating the position of the corner:**

I accepted the position of the 1/2" ir and set a 5/8" x 24" iron rod over the top of said ½" ir in a monument box and set an aluminum cap, stamped "Mason County Monument", on said 5/8" iron. I accepted this as a careful and faithful reestablishment of the position of the original corner.

On centerline N-S road  
PP West 37.82' #3  
PP East 34.59'  
SW corner of house N48E 134.38'  
SW corner small building N78E 106.80'

Signed by [Signature] Date 8-10-2000  
Surveyor's Michigan License No. 17634

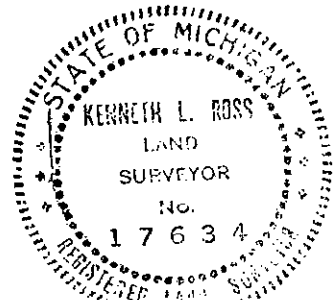

Approved by Peer Review Group on 8-10-2000  
Kenneth L. Ross, County Representative [Signature]

FORM APPROVED BY MICHIGAN STATE BOARD OF LAND SURVEYORS, JAN. 28, 1971  
REVISED MAY 14, 1976  
REVISED JAN. 1983  
ADAPTED FOR WORD PROCESSING MARCH, 1983