

SURVEY & RE-MONUMENTATION

JAN 28 2001

LAND CORNER RECORDATION CERTIFICATE

Filing Requirement of Act 74, Mich. P.A. 1970

SECTION

For corners In: Located In: Corner Code #
Mason County

- 1. Public Land Survey T 17N R 17W M-8
T 17N R 16W A-8 ✓
- 2. Property Controlling S _____ T _____ R _____
in Section S _____ T _____ R _____
- 3. Miscellaneous S _____ T _____ R _____
Property in Sec. S _____ T _____ R _____

- 4. Lot No. _____, Recorded Plat _____
- 5. Private Claims _____

FILED

AT 9:39 O'CLOCK A. M.

AUG 1 2000

MARGARET KOLASKI ELLIOTT
MASON COUNTY
REGISTER OF DEEDS

Register of Deeds Stamp & File Number

I, Kenneth L. Ross, in a field survey on May 4, 2000, Do hereby certify that under requirements of P.A. 74, Michigan P.A. of 1970, the corner points mentioned in lines 1 and 2 above were in conformance with regulations and rules therefore as required in the current manual of survey instructions of the United States Department of the Interior, Bureau of Land Management or by a decree of a Court of Law and/or that the corner points mentioned in lines 3, 4 and 5 above were in conformance with the rules of the Michigan Board of Land Surveyors or by a Decree of a Court of Law; established, re-established, monumented, re-monumented, recovered, found as expressed below:

$\frac{1}{4}$ corner common to sections 19 of T.17N, R.16W. and section 24 of T.17N., R17W.

A. Description of original monument and accessories and/or subsequent restoration:

- | | | |
|--|---|---|
| GLO 1837 Mullett & Brookfield set post.
Lynn 14 N72W 35 (23.10') #1
Beech 16 S58W 17 (11.22') #2 | Towns in sec. survey June 1903. "located this stake and planted stone with cross."
No witnesses given. | |
| Stephens RLS 7318 1957 unrecorded survey
"Ex. 1 1/4" pipe." (No witnesses) | MCRC (undated)
PP NW 47.0' #3
F. Corner West 31.6' #4 | Stephens RLS 7318 for Consumers Power 1968
Found 1 1/2" pipe
TP S15E 156.18' #9 |
| Ross PLS 17634
Used corner on unrecorded survey, no description of corner. | PP NE 62.3' #5
Iron pipe East 33.0' & 1.5' South #6 | PP Due West 31.88' #7
On E-W fence 1' W. of CL
PP N88E 69.44' #8 |

	A	B	C	D	E	F	G	H	I	J	K	L	M
1													
2	6	5	4	3	2	1							
3													
4	7	8	9	10	11	12							
5													
6	18	17	16	15	14	13							
7													
8	X 19	20	21	22	23	24	X						
9													
10	30	29	28	27	26	25							
11													
12	31	32	33	34	35	36							
13													

B. Description of corner evidence found and/or method applied in restoring or reestablishing corner:


I found a 1 1/2" pipe in an existing monument box 2 ft. west of the centerline of a N-S road.
Condition of witnesses: 1,2,3,5,6 and 9 are gone. 4, 7 and 8 are in good condition.
I found nothing to dispute the location of this corner

C. Description of monument for corner and accessories established to perpetuate locating the position of the corner:

I left the 1 1/2" pipe in the monument box intact and accepted this as a careful and faithful reestablishment of the position of the original corner. I did not add additional monument.

- Ex. PK in S. side of PP N87W 31.57' #7
- Ex. 60d spike in n. side PP N89E 69.43' #8
- Center of 12" spruce N32E 140.7' (no nail)
- NE corner of metal building N50W 83.75'

Signed by [Signature] Date 8-10-2000
Surveyor's Michigan License No. 17634

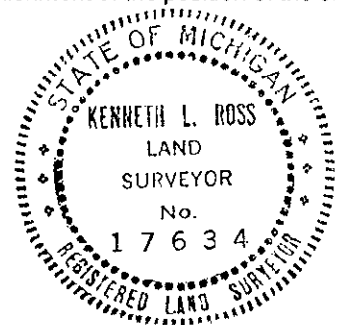

Approved by Peer Review Group on 8-10-2000
Kenneth L. Ross, County Representative [Signature]

FORM APPROVED BY MICHIGAN STATE BOARD OF LAND SURVEYORS, JAN. 28, 1971
REVISED MAY 14, 1978
REVISED JAN, 1983
ADAPTED FOR WORD PROCESSING MARCH, 1993