

# SURVEY & REMONUMENTATION

JAN 23 2001

## LAND CORNER RECORDATION CERTIFICATE

Filing Requirement of Act 74, Mich. P.A. 1976

### SECTION

For corners In: Located In: Corner Code #  
Mason County

- |                                       |                         |        |
|---------------------------------------|-------------------------|--------|
| 1. Public Land Survey                 | T 17N R 17W             | M-10   |
|                                       | T 17N R 16W             | A-10 ✓ |
|                                       | T _____ R _____         | _____  |
|                                       | T _____ R _____         | _____  |
| 2. Property Controlling in Section    | S _____ T _____ R _____ | _____  |
|                                       | S _____ T _____ R _____ | _____  |
| 3. Miscellaneous Property in Sec.     | S _____ T _____ R _____ | _____  |
|                                       | S _____ T _____ R _____ | _____  |
| 4. Lot No. _____, Recorded Plat _____ |                         |        |
| 5. Private Claims _____               |                         |        |

FILED

AT 9:40 O'CLOCK A. M

AUG 17 2000

MARGARET KOLASKI ELLIOTT  
MASON COUNTY  
REGISTER OF DEEDS

Register of Deeds Stamp & File Number

	A	B	C	D	E	F	G	H	I	J	K	L	M
1													
2	6	5	4	3	2	1							
3													
4	7	8	9	10	11	12							
5													
6	18	17	16	15	14	13							
7													
8	19	20	21	22	23	24							
9													
10	X 30	29	28	27	26	25	X						
11													
12	31	32	33	34	35	36							
13													

I, Kenneth L. Ross in a field survey on May 5, 2000, Do hereby certify that under requirements of P.A. 74, Michigan P.A. of 1970, the corner points mentioned in lines 1 and 2 above were in conformance with regulations and rules therefore as required in the current manual of survey instructions of the United States Department of the Interior, Bureau of Land Management or by a decree of a Court of Law and/or that the corner points mentioned in lines 3, 4 and 5 above were in conformance with the rules of the Michigan Board of Land Surveyors or by a Decree of a Court of Law; established, re-established, monumented, re-monumented, recovered, found as expressed below:

¼ corner common to section 30 of T.17N, R.16W., and Section 25 of T.17N., R.17W.

#### A. Description of original monument and accessories and/or subsequent restoration:

- |                                   |                            |
|-----------------------------------|----------------------------|
| GLO Mullett & Brookfield set post | Ross Act 74, L2 P47        |
| Beech 9 N15W 37 lks (24.42') #1   | Fd. 1 ½" pipe              |
| Beech 6 S65W 45 lks (29.70') #2   | Cent. Rd. N-S & E          |
|                                   | PP SW 48.73' #3            |
| Griswold B4 P 99                  | Rd. name sign SE 42.58' #4 |
| "Witness trees both down"         | 24" maple NE 122.75' #5    |
| Towns B3, P136, Sept. 1904        |                            |
| "located post by stake"           |                            |
| Towns B2, P117 & 118 Aug. 1904    |                            |
| "located post by stake"           |                            |

#### B. Description of corner evidence found and/or method applied in restoring or reestablishing corner:

I found a 1 ½" pipe in a monument box in the centerline of a road to the East and 0.6' West of the centerline of North-South Road. There is a tree line to the west.

Condition of witnesses: 1,2, and 4 are gone, 3 and 5 are in good condition.


I found nothing to dispute the location of this corner.

#### C. Description of monument for corner and accessories established to perpetuate locating the position of the corner:

I left the 1 ½" pipe in the monument box intact and accepted this a careful and faithful reestablishment of the position of the original corner. No additional monument was added.

- PP S47W 48.82' set mag nail NW side #3
- 11" poplar N83W 53.76' ex. 60d spike N. side
- 30" maple N21E 122.70' ex. 60d spike on E. side #5
- Top center of Telephone junction box N35E 48.34

Signed by Kenneth L. Ross Date 8-10-2000  
Surveyor's Michigan License No. 17634

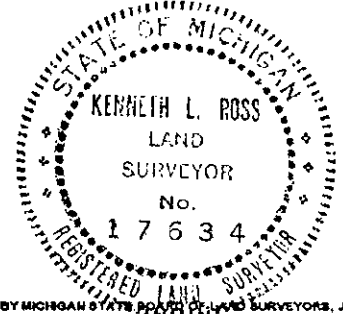

Approved by Peer Review Group on 8-12-2000  
Kenneth L. Ross, County Representative

FORM APPROVED BY MICHIGAN STATE BOARD OF LAND SURVEYORS, JAN. 28,

1971  
REVISED MAY 14, 1976  
REVISED JAN. 1983  
ADAPTED FOR WORD PROCESSING MARCH, 1993