

JAN 23 2001

SECTION

LAND CORNER RECORDATION CERTIFICATE

Filing Requirement of Act 74, Mich. P.A. 1970

For corners In: Located In: Corner Code # Mason County

- 1. Public Land Survey T 17N R 17W M-11 T 17N R 16W A-11
2. Property Controlling in Section S T R
3. Miscellaneous Property in Sec. S T R
4. Lot No. Recorded Plat
5. Private Claims

Register of Deeds Stamp & File Number. FILED AT 9:40 O'CLOCK A. M. AUG 17 2000 MARGARET KOLASKI ELLIOTT MASON COUNTY REGISTER OF DEEDS

Grid table with columns A-M and rows 1-13. Contains numbers 6 through 36.

I, Kenneth L. Ross, in a field survey on May 5, 2000, Do hereby certify that under requirements of P.A.74, Michigan P.A. of 1970, the corner points mentioned in lines 1 and 2 above were in conformance with regulations and rules therefore as required in the current manual of survey instructions of the United States Department of the Interior, Bureau of Land Management or by a decree of a Court of Law and/or that the corner points mentioned in lines 3, 4 and 5 above were in conformance with the rules of the Michigan Board of Land Surveyors or by a Decree of a Court of Law; established, re-established, monumented, re-monumented, recovered, found as expressed below:

Section corner common to section 30 and 31 of T17N., R16W., and Sections 25 and 36 of T.17N., R17W.

A. Description of original monument and accessories and/or subsequent restoration:

- GLO Mullett & Brookfield 1838 Set post Elm 10 S45W 42 lks (27.72') #1 Maple 9 N30W 38 lks (25.08')#2 Towns Sept. 1904 B3, P136 "located this corner by stone & planted " wagon skein".
Griswold B4, P99 "old witness trees" Ross, L245, P. 507, 8-4-78 Pipe in mon. box (no wit.)
Towns Aug. 1904 B2, P 117 & 118 "located this corner by stone & planted wagon skein". Ross L452, P180, 2-28-94 Iron in mon. box (no wit.) Ross L431, P293, 8-3-93 Mon. Box (no wit.)

B. Description of corner evidence found and/or method applied in restoring or reestablishing corner:


I found a 5/8" iron rod of undetermined length inside a monument box 3.1 ft. east of the centerline of N-S and on the centerline of a road to the West. Condition of witnesses: 1 & 2 are gone. I found nothing to dispute the location of this corner.

C. Description of monument for corner and accessories established to perpetuate locating the position of the corner:

I placed a 2 1/4" aluminum cap that is stamped "Mason County Monument " on the existing 5/8" Ir. I accepted this as a careful and faithful reestablishment of the position of the original corner. No additional monumentation was added.

- PP N14E 124.49' ex. PK on west side
PP N 13W 167.81' ex. PK on west side
SW corner of pad for Ameritech box N26E 47.90'
NE corner of House N49E 147.45'

Signed by [Signature] Date 8-10-2000 Surveyor's Michigan License No. 17634

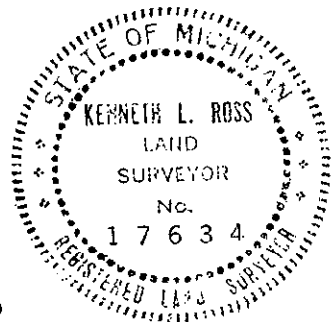

Approved by Peer Review Group on 8-10-2000 Kenneth L. Ross, County Representative [Signature]

FORM APPROVED BY MICHIGAN STATE BOARD OF LAND SURVEYORS, JAN. 28, 1971 REVISED MAY 14, 1978 REVISED JAN., 1983 ADAPTED FOR WORD PROCESSING MARCH, 1993