

**SURVEY & REMONUMENTATION**

MAR 16 1998

LIBER -- 4 PAGE 121

**SECTION**

**LAND CORNER RECORDATION CERTIFICATE**

Filing Requirement of Act 74, Mich. P.A. 1970


For corners in  
MASON  
(County)

Located in:

Corner Code #

- 1. Public Land Survey
  - T 18 NR 16 W
  - T 17 NR 16 W
  - T \_\_\_\_\_ R \_\_\_\_\_
  - T \_\_\_\_\_ R \_\_\_\_\_
- 2. Property Controlling In Section
  - S \_\_\_\_\_ T \_\_\_\_\_ R \_\_\_\_\_
  - S \_\_\_\_\_ T \_\_\_\_\_ R \_\_\_\_\_
- 3. Miscellaneous Property in Sec.
  - S \_\_\_\_\_ T \_\_\_\_\_ R \_\_\_\_\_
  - S \_\_\_\_\_ T \_\_\_\_\_ R \_\_\_\_\_

B-13  
B-1 ✓

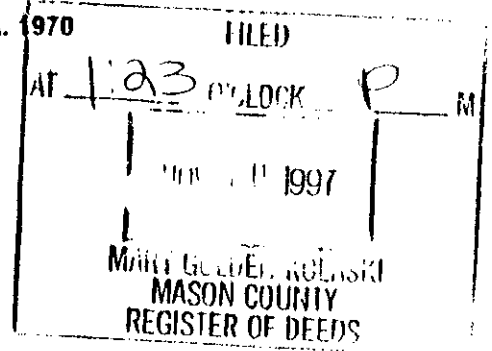

Register of Deeds Stamp & File Number

- 4. Lot No. \_\_\_\_\_, Recorded Plat \_\_\_\_\_
- 5. Private Claims \_\_\_\_\_

I, Sammy S. Barnett, in a field survey on Sept. 15th 1997, do hereby certify that under requirements of P.A. 74, Michigan P.A. of 1970, the corner points mentioned in lines 1 and 2 above were in conformance with regulations and rules therefore as required in the current manual of survey instructions of the United States Department of the Interior, Bureau of Land Management or by a decree of a Court of Law and/or that the corner points mentioned in lines 3, 4 and 5 above were in conformance with the rules of the Michigan Board of Land Surveyors or by a Decree of a Court of Law; established, re-established, monumented, re-monumented, recovered, found as expressed below:

	A	B	C	D	E	F	G	H	I	J	K	L	M
1													
2		6	5	4	3	2	1						
3													
4		7	8	9	10	11	12						
5													
6		16	17	16	15	14	13						
7													
8		19	20	21	22	23	24						
9													
10		30	29	28	27	26	25						
11													
12		31	32	33	34	35	36						
13													

NOTE: Not more than 4 corners, all in the same town and range, may be recorded on this certificate.

**A Description of original monument and accessories and/or subsequent restoration:**

B - 13 South one-quarter corner, section 31 T18N, R16W

1838 GLO survey by Mullett & Brookfields  
Set post  
# 1 Hem 12" N47W 28 lks (18.48')  
# 2 Hem 12" N38E 21 lks (13.86')

1894 survey by J.W. Griswold  
Monument not given, set by old trees.

1959 Mason Co. Road Comm. witnesses  
Iron  
# 3 T.P. SW 53.8'  
# 4 P.P. NW 58.4  
# 5 P.P. NW 86.2'  
# 6 Cherry Stump 18" North 66.5'  
# 7 Elm (no size) South 33.0'

1997 survey by K. Ross, mon. not given  
no witnesses.

Undated R. O. Towns survey ident.  
by old stumps planted stake & crockery

**B. Description of corner evidence found and/or method applied in restoring or reestablishing corner:**

B - 13 South one-quarter corner, section 31 T18N, R16W

On Sept. 15th 1997 I found a 60d spike over a 1" pipe approximately 2' North of the centerline of the East-west blacktop road, the condition of the witnesses is as follows,

# 1 Gone # 2 Gone # 3 Gone # 4 cut off # 5 Gone # 6 Cut off flush with the ground # 7 Gone

**C. Description of monument for corner and accessories established to perpetuate locating the position of the corner:**

B - 13 South one-quarter corner, section 31 T18N, R16W

On Sept 15th 1997, I replaced the found 60d spike with a Standard Mason County Monument driven in to the 1" pipe and accepted this location as the best available evidence of the position of the original corner, and took the following witnesses.

- # 8 Power pole # 49 N57W 60.98' existing roofing nail in SW side
- # 9 K. Ross capped iron North 33.00'
- # 11 Distance East 2629.26' to C - 13
- # 12 Distance West 2606.59' to A - 13

Corner falls in approximately 4' of cut in road, Corner is in a monument box.

This corner has also been commonly accepted as B - 1 the north one-quarter corner of section 6 T17N R16W which was not set by original GLO survey.

Signed by Sammy S. Barnett

Date 11-4-97

Surveyor's Michigan License No. P S # 16923

FORM APPROVED BY MICHIGAN STATE BOARD OF LAND SURVEYORS, JAN. 26, 1971  
REVISED MAY 14, 1975  
REVISED JAN., 1983

Peer Group Reviewed and Approved  
Date: Oct 23 1997  
L. Ruth L. Ross  
Mason County Surveyor