

SURVEY & REMONUMENTATION

JAN 23 2001


LAND CORNER RECORDATION CERTIFICATE

Filing Requirement of Act 74, Mich. P.A. 1970

SECTION

For corners In: Located In: Corner Code #
Mason County

- | | | | |
|------------------------------------|--------------|--------------|---------|
| 1. Public Land Survey | T <u>17N</u> | R <u>16W</u> | B-5 |
| | T _____ | R _____ | _____ |
| | T _____ | R _____ | _____ |
| | T _____ | R _____ | _____ |
| 2. Property Controlling in Section | S _____ | T _____ | R _____ |
| | S _____ | T _____ | R _____ |
| 3. Miscellaneous Property in Sec. | S _____ | T _____ | R _____ |
| | S _____ | T _____ | R _____ |

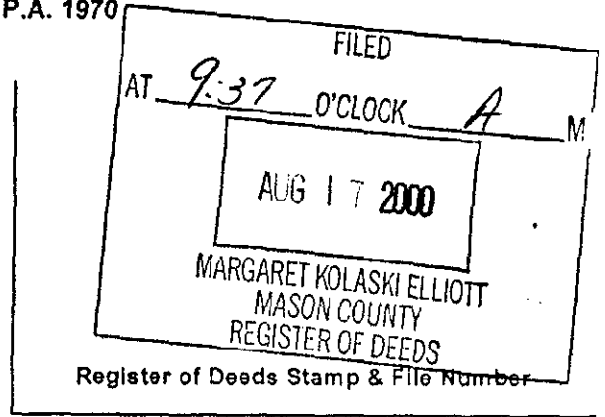

4. Lot No. _____ Recorded Plat _____
5. Private Claims _____

	A	B	C	D	E	F	G	H	I	J	K	L	M
1													
2	6	5	4	3	2	1							
3													
4	7	8	9	10	11	12							
5	18	17	16	15	14	13							
6													
7	19	20	21	22	23	24							
8													
9	30	29	28	27	26	25							
10													
11	31	32	33	34	35	36							
12													
13													

Kenneth L. Ross, in a field survey on May 4, 2000 Do hereby certify that under requirements of P.A. 74, Michigan P.A. of 1970, the corner points mentioned in lines 1 and 2 above were in conformance with regulations and rules therefore as required in the current manual of survey instructions of the United States Department of the Interior, Bureau of Land Management or by a decree of a Court of Law and/or that the corner points mentioned in lines 3, 4 and 5 above were in conformance with the rules of the Michigan Board of Land Surveyors or by a Decree of a Court of Law; established, re-established, monumented, re-monumented, recovered, found as expressed below:

1/4 corner common to Sections 7 and 18, T17N., R16W.

1. Description of original monument and accessories and/or subsequent restoration:

GLO Hodgson 1838 Beech 7 S53E 23 lks (15.18') #1 Beech 8 N38W 23 lks (15.18') #2	Gordon Bonney PLS 12016 Liber 418 Page 758 Act 132 7-20-92 Same witnesses as Act 74,
--	---

Gordon Bonney PLS 12016 filed Act 74
Liber 3 page 83 (1992)
Found RR spike
2P N10W 43.75' #3
2P S45W 52.65' #4
2P N70E 107.45' #5
in cen. line E-W Rd.

3. Description of corner evidence found and/or method applied in restoring or reestablishing corner:

found the RR spike as described by Bonney and replaced with a standard 4" x 18 1/2" Harrison Cast iron Monument, stamped "Mason County Monument".

Condition of witnesses: 1 & 2 Gone, Found #3 and 5 with no nail, #4 was gone


There is a ditch to the South but no N-S fence lines or definitive occupation lines.

found no evidence to dispute the location of this corner.

2. Description of monument for corner and accessories established to perpetuate locating the position of the corner:

replaced the existing spike with a 4" x 18 1/2" Harrison Cast Iron Monument in a monument box, stamped "Mason County Monument". accepted this as a careful and faithful reestablishment of the position of the original corner.

- 2P N11W 45.78' (Set Mag nail East side) #3
- 2P N58E 107.71' (Set Mag nail SE side) #5
- 2P S50E 58.44' (Set Mag nail SW side) #6
- SW corner Sub-station fence N33E 109.29' #7

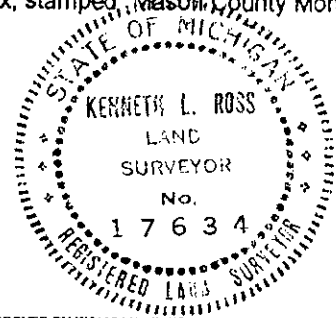

Signed by [Signature] Date 8-10-2000
Surveyor's Michigan License No. 17634

Approved by Peer Review Group on 8-10-2000
Kenneth L. Ross, County Representative [Signature]

FORM APPROVED BY MICHIGAN STATE BOARD OF LAND SURVEYORS. JAN. 28, 1977
REVISED MAY 14, 1975
REVISED JAN. 1983
ADAPTED FOR WORD PROCESSING MARCH, 1993