


**LAND CORNER RECORDATION CERTIFICATE**  
**Filing Requirement of Act 74, Mich. P.A. 1970**

For corners in

<b>MASON</b> (County)	Located in:	Corner Code //
1. Public Land Survey	T 17N R 16W	C-12
	T .. R	
	T .. R	
	T .. R	
2. Property Controlling in Section	S .. T .. R	
	S .. T .. R	
3. Miscellaneous Property in Sec.	S .. T .. R	
	S .. T .. R	

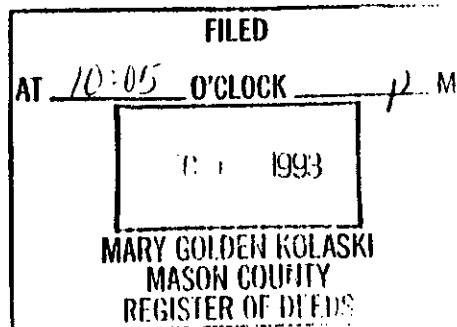

Register of Deeds Stamp & File Number

4. Lot No. \_\_\_\_\_ ; Recorded Plat \_\_\_\_\_  
 5. Private Claims \_\_\_\_\_

	A	B	C	D	E	F	G	H	I	J	K	L	M
2		6		5		4		3		2			
3													
4		7		8		9		10		11		12	
5													
6		18		17		16		15		14		13	
7													
8		19		20		21		22		23		24	
9													
10		30		29		28		27		26		25	
11													
12		31		32		33		34		35		36	
13													

I, **John Schulke**, in a field survey on **Oct. 18**, 19**93**, do hereby certify that under requirements of P.A. 74, Michigan P.A. of 1970, the corner points mentioned in lines 1 and 2 above were in conformance with regulations and rules therefore as required in the current manual of survey instructions of the United States Department of the Interior, Bureau of Land Management or by a decree of a Court of Law and/or that the corner points mentioned in lines 3, 4 and 5 above were in conformance with the rules of the Michigan Board of Land Surveyors or by a Decree of a Court of Law; established, re-established, monumented, re-monumented, recovered, found as expressed below:

**NOTE: Not more than 4 corners, all in the same town and range, may be recorded on this certificate.**

**A. Description of original monument and accessories and/or subsequent restoration:**

**C-12 Original survey established in 1838 by Hogenson.**

Set a wooden post with the following references:

- Hemlock 12" S47°W 12 lks.
- Hemlock 6" N65°E 14 lks.

In 1877, J.W. Griswold established post by measurement. The following bearing trees: Dead Hemlock bears S16°W a distance of 18 lks. (see Mason Co. Surveyors Record Book 1, page 95 in the Mason Co. Register of Deed's Office).

In 1958, Mason Co. Road Commission indicated iron and stone at the corner. The following corner

- references: Power pole SE 58.3 ft.
- Stump 30" SW 65.3 ft.

In 1969, K. Stephens surveyed Section 32 for the Consumer Power Co. Found iron at the corner. The following corner references:

- Road name sign S55°E 48.97 ft.
- Stop sign S50°W 23.3 ft.
- Stop sign N80°E 37.0 ft.

In 1973, J. Borsfay following road construction reset corner from corner references. Set 1" dia. X 25" pipe with the following corner references:

- Power pole SE 58.3 ft.
- Maple 10" NE 99.14 ft.
- Willow 8" NE 100.60 ft.

In 1988, Gordon Bonney used corner to established the Center Quarter to Section 31. No references (see Liber 372, page 769 in the Mason Co. Register of Deed's Office).


**B. Description of corner evidence found and/or method applied in restoring or reestablishing corner.**

**C-12 Found monument box with 3/4" solid iron bar inside 1" pipe on center line of Darr Road. The center line of Major's Road bears South 2 feet.**

**C. Description of monument for corner and accessories established to perpetuate locating the position of the corner:**

**C-12 Accepted 3/4" solid iron bar as the best available evidence. Replaced iron bar with 5/8" dia. X 24" iron rebar with an aluminum County cap stamped to identify the corner. The following references:**

- Power pole #68 S54°E 58.74 ft.
- Stop sign N77°E 40.77 ft.
- Road & Stop sign S79°W 55.45 ft.
- Sugar Maple 13" N64°W 149.0 ft.
- Sug. Maple (clump) 10" S21°W 101.16 ft.

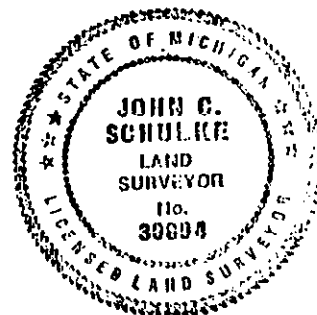

Signed by *John C. Schulke*  
 Surveyor's Michigan License No. **RLS-30894**

Date **Nov 18, 1993**

Peer Group Review APPROVED BY MICHIGAN STATE BOARD OF LAND SURVEYORS, JAN 28 1971  
 and Approved  
 Date: *12-9-93*  
 Revised JAN 1983

*[Signature]*  
 Mason County Surveyor