


**LAND CORNER RECORDATION CERTIFICATE**  
Filing Requirement of Act 74, Mich. P.A. 1970

For corners in

<u>MASON</u> (County)	Located In:	Corner Code #:
1. Public Land Survey	T 17N R 16W	C-13
	T _____ R _____	_____
	T _____ R _____	_____
	T _____ R _____	_____
2. Property Controlling in Section	S _____ T _____ R _____	_____
	S _____ T _____ R _____	_____
3. Miscellaneous Property in Sec.	S _____ T _____ R _____	_____
	S _____ T _____ R _____	_____

4. Lot No. \_\_\_\_\_, Recorded Plat \_\_\_\_\_  
5. Private Claims \_\_\_\_\_

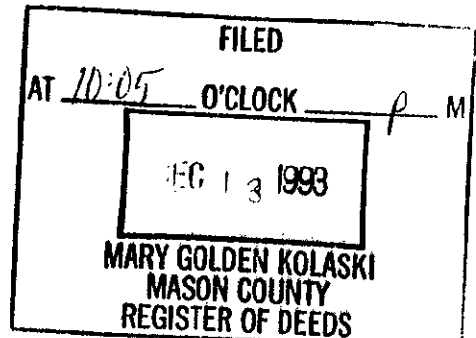

Register of Deeds Stamp & File Number

I, John Schulke, in a field survey on Nov. 17, 1993, do hereby certify that under requirements of P.A. 74, Michigan P.A. of 1970, the corner points mentioned in lines 1 and 2 above were in conformance with regulations and rules therefore as required in the current manual of survey instructions of the United States Department of the Interior, Bureau of Land Management or by a decree of a Court of Law and/or that the corner points mentioned in lines 3, 4 and 5 above were in conformance with the rules of the Michigan Board of Land Surveyors or by a Decree of a Court of Law; established, re-established, monumented, re-monumented, recovered, found as expressed below:

**NOTE: Not more than 4 corners, all in the same town and range, may be recorded on this certificate.**

A	B	C	D	E	F	G	H	I	J	K	L	M
2	6	5	4	3	2							
3												
4	7	8	9	10	11	12						
5												
6	18	17	16	15	14	13						
7												
8	19	20	21	22	23	24						
9												
10	30	29	28	27	26	25						
11												
12	31	32	33	34	35	36						
13												

**A. Description of original monument and accessories and/or subsequent restoration:**

C-13 Original survey established in 1838 by Mullet. Set a wooden post as the corner to Sections 31 and 32. The following corner references:  
Beech 10" N28°W 30 lks.  
Beech 10" N16°E 37 lks.  
  
In 1838, Hogenson set corner to Sections 5 and 6 bears West a distance of 20 lks. from corner of Sections 31 and 32.  
  
In 1877, J.W. Griswold established post by measurement. The following bearing trees:  
Hemlock 10" N33°W 28 lks.  
Hemlock 10" N22°E 24 lks.

(see the Mason Co. Surveyors Record Book 1, page 95 in the Mason Co. Register of Deed's Office).

In 1958, the Mason Co. Road Commission found iron. The following corner references:  
Stop sign NW 64.8 ft.  
Power pole NW 64.5 ft.  
Cherry SE 41.8 ft.  
Road name sign NW 45.6 ft.

In 1968, Consumer Power Surveyed Section 5, T16N, R16W, by George Blass shows two irons 13.12 feet apart.

In 1969, K. Stephens surveyed Section 32 for the Consumer Power Co. and found 1/2" iron pipe at the corner. The closing corner to Sections 5 and 6 bears West a distance of 13.12 feet. The following references:  
W Cherry 20" S40°E 31.15 ft.  
Jack Pine 8" S51°W 84.79 ft.  
Power pole N65°W 76.48 ft.

**B. Description of corner evidence found and/or method applied in restoring or reestablishing corner.**

C-13 Found 5/8" iron with recorded iron 13.1 ft. West. Center line of Darr Road bears West 14.4 ft. Center line of Washington Road bears South 3 feet. Found pointed wood stake N40°W a distance of 0.2 ft. from the iron stake (2 feet below road surface). NOTE: The road commission ties appear to be for the closing corner of Sections 5 and 6. Found 1" iron pipe in monument box as the Closing Corner for Sections 5 and 6, T16N, R16W, N82°W a distance of 13.26 ft.

In 1972, S. Barnett filed a Land Corner Recordation Certificate in the Oceana Co. Register of Deed's Office.

In 1973, J. Borsfay (Mason Co. Road Commission) found 1" pipe at the corner. The following corner references:  
Power pole NW 64.75 ft.  
Cherry 16" SE 42.12 ft.

In 1977, J. Kistler & Assoc., Inc. filed a Legal Description (see Jacket #206, 1 of 1 in the Oceana Co. Register of Deed's Office).

**C. Description of monument for corner and accessories established to perpetuate locating the position of the corner:**

C-13 Accepted iron as the best available evidence. Replaced iron with a 5/8" dia. X 24" iron rebar with an aluminum County cap stamped to identify the corner. The following corner references:  
Power pole #36 N65°W 205.06 ft.  
Snowmobile sign N11°E 88.70 ft.  
Wild Blk. Cherry 20" S63°E 56.72 ft.  
Power pole #37 N45°E 38.90 ft.  
Stop sign S75°W 48.53 ft.  
NOTE: Set monument box surrounding the 5/8" rebar.



Signed by John C. Schulke  
Surveyor's Michigan License No. RLS-30894

Date Nov 18, 1993

Peer Group Reviewed  
FORM APPROVED BY MICHIGAN STATE BOARD OF LAND SURVEYORS, JAN. 26, 1971  
Date 12-9-93  
[Signature]  
Mason County Surveyor  
REVISED MAY 14, 1975  
REVISED JAN., 1983