

SURVEY & REMONUMENTATION LAND CORNER RECORDATION CERTIFICATE

LIBER -- 4 PAGE 124

MAR 16 1998


Filing Requirement of Act 74, Mich. P.A. 1970

For corners in
MASON Located in: _____ Corner Code # _____
 (County) SECTION

1. Public Land Survey T 18 NR 16 W
 T 17 NR 16W
 T _____ R _____
 T _____ R _____

2. Property Controlling S _____ T _____ R _____
 In Section S _____ T _____ R _____

3. Miscellaneous S _____ T _____ R _____
 Property in Sec. S _____ T _____ R _____

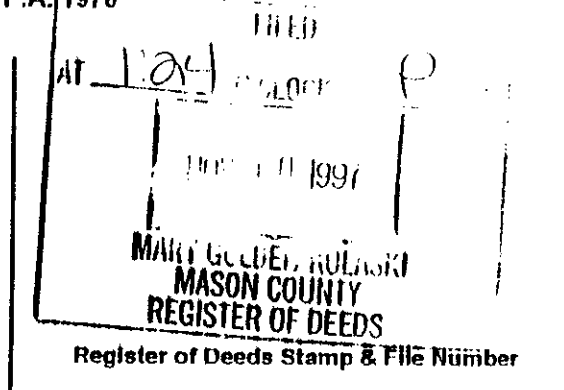

4. Lot No. _____ Recorded Plat _____
 5. Private Claims _____

I, Sammy S. Barnett, in a field survey on Sept. 15th 19 97, do hereby certify that under requirements of P.A. 74, Michigan P.A. of 1970, the corner points mentioned in lines 1 and 2 above were in conformance with regulations and rules therefore as required in the current manual of survey instructions of the United States Department of the Interior, Bureau of Land Management or by a decree of a Court of Law and/or that the corner points mentioned in lines 3, 4 and 5 above were in conformance with the rules of the Michigan Board of Land Surveyors or by a Decree of a Court of Law, established, re-established, monumented, re-monumented, recovered, found as expressed below:

	A	B	C	D	E	F	G	H	I	J	K	L	M
1													
2	6	5			4		3			2			1
3													
4	7	8			9		10			11			12
5													
6	18	17			16		15			14			13
7													
8	19	20			21		22			23			24
9													
10	30	29			28		27			26			25
11													
12	31	32			33		34			35			36
13													

NOTE: Not more than 4 corners, all in the same town and range, may be recorded on this certificate.

A. Description of original monument and accessories and/or subsequent restoration:

- E - 13 Corner common to sections 32 & 33 T18N, R16W & E - 1 sections 4 & 5 T17N, R16W
- 1838 GLO survey by Mullett & Brookfields Set post
 - # 1 Beech 14" N61E 8 lks (5.28')
 - # 2 Beech 10" N54W 40 lks (26.4')
- 1886 survey by W.E. Metcalf Monument not given, found stumps of Government witnesses.
- 1890 survey by W.E. Metcalf Monument not given Stump remains of Government witnesses.
- 1958 Mason Co. Rd. Comm. wit. Iron in tile stones above
 - # 3 T.P. NW 46.2'
 - # 4 T.P. NE 39.5'
 - # 5 T.P. SE 68.0'
 - # 6 P.P. SW 61.3'
- 1879 survey by J.H. Jones Monument not given, identified by old trees.
- 1971 by J. Borzsfay found 1/2" re-bar & wood stake surfaced with 1" pipe, placed Mon. box.
- 1988 & 1992 surveys by K. Ross, iron in Mon box no witnesses

B. Description of corner evidence found and/or method applied in restoring or reestablishing corner:

E - 13 Corner common to sections 32 & 33 T18N, R16W & E - 1 sections 4 & 5 T17N, R16W

On Sept. 15th I found a 1" pipe in an existing monument box approximately 4' North of the centerline of the East-west blacktop road and in the centerline of the North-south gravel roads, condition of the witnesses is as follows,
 # 1 Gone # 2 Gone # 3 Gone # 4 gone # 5 Gone # 6 Gone

C. Description of monument for corner and accessories established to perpetuate locating the position of the corner:

E - 13 Corner common to sections 32 & 33 T18N, R16W & E - 1 sections 4 & 5 T17N, R16W

On Sept 15th 1997 I drove a Standard Mason County Monument inside the found 1" pipe and accepted this location as the best available evidence of the position of the original corner, and took the following witnesses.

- # 7 "X" on South end of con. headwall N33E 30.22'
- # 8 Guy pole # 74 842W 51.55' set PK in NW side
- # 9 "X" on South end of con. headwall N22W 31.05'
- # 10 Power pole N56W 52.28' set PK in SW side

Corner falls in approximately 3' of fill, Corner is in a monument box.



Signed by Sammy S. Barnett Date 1-4-97
 Surveyor's Michigan License No. PS # 16923

Pect Group Reviewed and Approved
 Date: Oct 2 1997
Kenneth L. Ross
 Mason County Surveyor