

1993

COMMISSION

LAND CORNER RECORDATION CERTIFICATE
Filing Requirement of Act 74, Mich. P.A. 1970


For corners in

_____ MASON _____ (County) Located In: _____ Corner Code # _____

1. Public Land Survey T 17NR 16W E-4
 T _____ R _____
 T _____ R _____
 T _____ R _____

2. Property Controlling S _____ T _____ R _____
 in Section S _____ T _____ R _____

3. Miscellaneous S _____ T _____ R _____
 Property in Sec. S _____ T _____ R _____

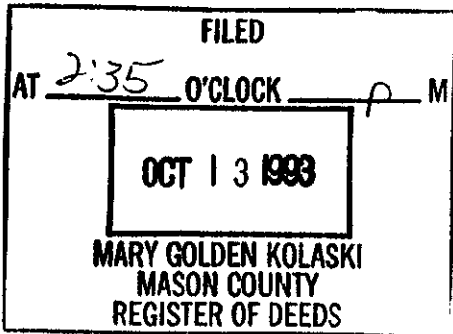

Register of Deeds Stamp & File Number

4. Lot No. _____, Recorded Plat _____
 5. Private Claims _____

I, Kenneth L. Ross, in a field survey on OCTOBER, 19 93, do hereby certify that under requirements of P.A. 74, Michigan P.A. of 1970, the corner points mentioned in lines 1 and 2 above were in conformance with regulations and rules therefore as required in the current manual of survey instructions of the United States Department of the Interior, Bureau of Land Management or by a decree of a Court of Law and/or that the corner points mentioned in lines 3, 4 and 5 above were in conformance with the rules of the Michigan Board of Land Surveyors or by a Decree of a Court of Law; established, re-established, monumented, re-monumented, recovered, found as expressed below:

NOTE: Not more than 4 corners, all in the same town and range, may be recorded on this certificate.


A	B	C	D	E	F	G	H	I	J	K	L	M
2	6	5	4	3	2	1						
3												
4	7	8	9	10	11	12						
5												
6	18	17	16	15	14	13						
7												
8	19	20	21	22	23	24						
9												
10	30	29	28	27	26	25						
11												
12	31	32	33	34	35	36						
13												

A. Description of original monument and accessories and/or subsequent restoration:

- E-3 Section Corner, Secs. 4, 5, 8, & 9
1838 John Hodgeson set Post
18" Beech S 24 E 30 lks
10" Beech N. 41 W 46 lks
- E-4 1/4 Corner, Secs. 8 & 9
1838 John Hodgeson set Post
12" Beech N 65 W 20 lks
12" Beech S 40 E 38 lks

B. Description of corner evidence found and/or method applied in restoring or reestablishing corner:

- E-3 Section Corner, Secs. 4, 5, 8, & 9
Ross 1980 Fd 5/8" Iron rod & crockery
took 3 witness
Rd Name Sign NW 47.90'
F. Post SE 37.88'
4" Apple SW 63.00'
- E-4 1/4 Corner, Secs. 8 & 9
Ross 1980 set 5/8" Iron rod Fence E-W, N;
in center line Trail N took 3 witness
12" R. Oak NNE 38.74'
8" W. Pine W 66.33'
18" Maple SE 59.65'

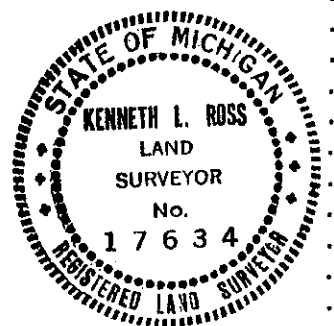

C. Description of monument for corner and accessories established to perpetuate locating the position of the corner:

- E-3 Section Corner, Secs. 4, 5, 8, & 9
Found 5/8" Iron pipe 1' below surface in center line N-S road, 3' S of center line E-W road, replaced with 5/8" X 36" re-bar with 2 1/2" alum. cap, and is accepted as the best available evidence of the original corner.
Rd Name Sign Post N 39' W 47.89'
6" Poplar N 44 E 61.18' Wood Post S 47 E 37.66'
CL Tele Box S 52 E 35.32' 6" Maple S 08 E 114.21'
Coy Fence Post S 40 W 44.39' T Box S 85 W 287.56'
N 1/4 cor Sec. 9 N 89-07-11 E 2658.89'
W 1/4 cor Sec. 9 S 01-19-51 E 2626.35'
- E-4 1/4 Corner, Secs. 8 & 9
Found Ross capped Iron as Per Ross Surveys Dwg. File # 233885 at fence intersection, replaced with 5/8" X 36" re-bar with 2 1/2" alum. cap, and is accepted as the best available evidence of the original corner.
8" W. Pine N 77 W 66.25'
6" W. Pine S 61 W 46.86'
18" Maple S 63 E 59.65'
12" R. Oak N 08 E 38.36'

Peer Group Reviewed and Approved
 Date: 10-12-93
 Kenneth L. Ross
 Mason County Surveyor

Signed by _____ Date 10-12-93

Surveyor's Michigan License No. 17634