

**SURVEY &
REMONUMENTATION**

MAR 16 1998

LIBER -- 4 PAGE 116

SECTION

LAND CORNER RECORDATION CERTIFICATE

Filing Requirement of Act 74, Mich. P.A. 1970


For corners in
MASON
 (County)

Located In: _____ Corner Code # _____

1. Public Land Survey T 17 NR 16 W F-1
 T _____ R _____
 T _____ R _____
 T _____ R _____

2. Property Controlling S _____ T _____ R _____
 in Section S _____ T _____ R _____

3. Miscellaneous S _____ T _____ R _____
 Property in Sec. S _____ T _____ R _____

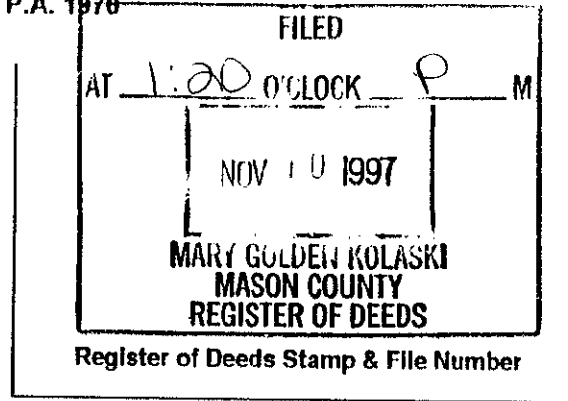

4. Lot No. _____, Recorded Plat _____
 5. Private Claims _____

I, Sammy S. Barnett, in a field survey on Sept. 22th 19 97, do hereby certify that under requirements of P.A. 74, Michigan P.A. of 1970, the corner points mentioned in lines 1 and 2 above were in conformance with regulations and rules therefore as required in the current manual of survey instructions of the United States Department of the Interior, Bureau of Land Management or by a decree of a Court of Law and/or that the corner points mentioned in lines 3, 4 and 5 above were in conformance with the rules of the Michigan Board of Land Surveyors or by a Decree of a Court of Law; established, re-established, monumented, re-monumented, recovered, found as expressed below:

NOTE: Not more than 4 corners, all in the same town and range, may be recorded on this certificate.

	A	B	C	D	E	F	G	H	I	J	K	L	M
1													
2	6	5	4	3	2	1							
3													
4	7	8	9	10	11	12							
5													
6	18	17	16	15	14	13							
7													
8	19	20	21	22	23	24							
9													
10	30	29	28	27	26	25							
11													
12	31	32	33	34	35	36							
13													

A. Description of original monument and accessories and/or subsequent restoration:


F - 1 North one-quarter corner of section 4 T17, R16W
 Not set by GLO survey Undated road survey by C.E. Mitchell (est. 1911
 Monument not given
 1886 Survey by C.E. Metcalf # 1 T. P. N24-30E 51.8'
 Round stone # 2 Apple 6" S20-30E 51.5'
 # 3 Maple 3" S46-00W 42.'

B. Description of corner evidence found and/or method applied in restoring or reestablishing corner:

F - 1 North one-quarter corner of section 4 T17N, R16W
 On Sept 22th 1997 I found an existing 1/2" rebar in the centerline of the East-West blacktop road and in line with an old fence line to the South, EDM measurements were made to G - 1, 2642.57' and E - 1, 2642.59', condition of the existing witnesses are as follows,
 # 1 Gone # 2 Gone # 3 Gone

C. Description of monument for corner and accessories established to perpetuate locating the position of the corner:

F - 1 North one-quarter corner of section 4 T17, R16W
 On Sept 22th 1997 I replaced the found 1/2" rebar with a Standard Mason County Monument. This position was not established by the original government survey. This monument is accepted as the best available evidence of the position of the corner. I took the following witnesses,
 # 4 Fence post N62E 46.95' set PK nail in SE side
 # 5 4' pipe fence post South 32.70' center line of pipe
 # 6 Guy pole S40W 44.68' set PK nail in SE side
 # 7 Power pole N38W 46.35' set PK nail in NE side
 # 8 Standard Mason Co. Mon. West 4.64' (F 13 T18N, R16W)
 Corner falls in centerline of East-West blacktop road in approximately 4' of fill.
 Corner is in a monument box.

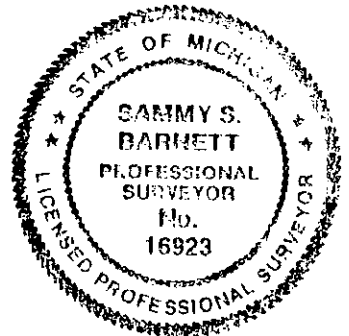

Signed by Sammy S. Barnett Date 11-4-97
 Surveyor's Michigan License No. P S # 16923

FORM APPROVED BY MICHIGAN STATE BOARD OF LAND SURVEYORS, JAN. 28, 1971
 REVISED MAY 14, 1975
 REVISED JAN. 1983

Peer Group Reviewed
 and Approved
 Date: Oct 2, 1997
Kenneth L. Ross
 Mason County Surveyor

LIBER - 4 PAGE 116