

**SURVEY &
REMONUMENTATION**

MAR 16 1998

LIBER -- 4 PAGE 115

SECTION LAND CORNER RECORDATION CERTIFICATE

Filing Requirement of Act 74, Mich. P.A. 1970

For corners in
MASON
(County)

Located In: _____ Corner Code # _____


1. Public Land Survey T 17 NR 16 W G-1
T _____ R _____
T _____ R _____
T _____ R _____

2. Property Controlling S _____ T _____ R _____
in Section S _____ T _____ R _____

3. Miscellaneous S _____ T _____ R _____
Property in Sec. S _____ T _____ R _____

4. Lot No. _____, Recorded Plat _____

5. Private Claims _____

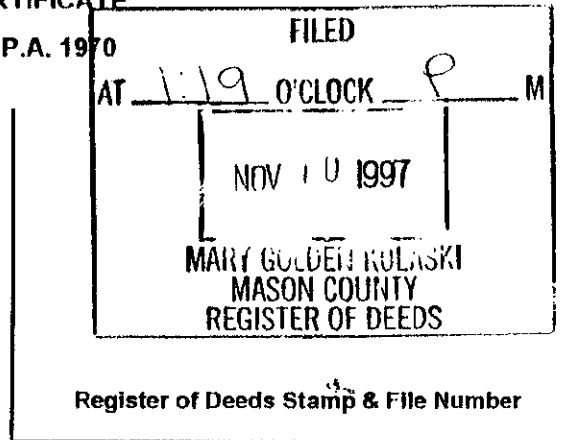

1	A	B	C	D	E	F	G	H	I	J	K	L	M
2		6	5	4	3	2	1						
3													
4		7	8	9	10	11	12						
5													
6		18	17	16	15	14	13						
7													
8		19	20	21	22	23	24						
9													
10		30	29	28	27	26	25						
11													
12		31	32	33	34	35	36						
13													

I, Sammy S. Barnett, in a field survey on Sept. 15th 19 97, do hereby certify that under requirements of P.A. 74, Michigan P.A. of 1970, the corner points mentioned in lines 1 and 2 above were in conformance with regulations and rules therefore as required in the current manual of survey instructions of the United States Department of the Interior, Bureau of Land Management or by a decree of a Court of Law and/or that the corner points mentioned in lines 3, 4 and 5 above were in conformance with the rules of the Michigan Board of Land Surveyors or by a Decree of a Court of Law; established, re-established, monumented, re-monumented, recovered, found as expressed below:

NOTE: Not more than 4 corners, all in the same town and range, may be recorded on this certificate.

A. Description of original monument and accessories and/or subsequent restoration:

G - 1 Corner common to sections 3 & 4 T17N, R16W
1839 GLO survey by J. Hodgson
set post 10 lks (6.6') East of section post

- # 1 Sugar 12" S23W 24 lks (15.84')
- # 2 B. Ash 18" S4E 55 lks (36.3')

1886 survey by Metcalf, used
Griswolds stake which he set
from Gov't witnesses & testimony
3 Basswood 24" N75E 66 lks (43.56')
4 Hem. stump 30" N41E 50.5lks (33.33')

1896 petition survey
by Metcalf, Mon. not
given, Cor. to 3 & 4
is set 10 lks East
of cor. 34, & 35 no
witnesses

1970 Mason Co road comm. by J. Borsfay
found 3/4" iron rod, bearings are for W. cor.,
5 1/2" bolt East 9.20'
6 P.P. NW 70.3'
7 Maple 18" NE 63.97'
8 P.P. NE 59.15'

B. Description of corner evidence found and/or method applied in restoring or reestablishing corner:

G - 1 Corner common to sections 3 & 4 T17N, R16W

On Sept. 15th I found a 1" x 12" pipe in an existing monument box, condition of the witnesses is as follows,
1 Gone # 2 Gone # 3 Gone # 4 Gone # 5 Gone # 6 Gone # 7 Gone # 8 Gone

C. Description of monument for corner and accessories established to perpetuate locating the position of the corner:

G - 1 Corner common to sections 3 & 4 T17N, R16W


On Sept 15th 1997, I replaced the found 1" pipe with a Standard Mason County Monument and accepted this location as the best available evidence of the position of the original corner, and took the following witnesses.

- # 9 Maple 24" N30E 60.52' set 60d spike in SE side
- # 10 Power pole # ENF 79 E 1 N72E 50.25' set 60d spike in S. side
- # 11 Guy pole S22E 60.71' set PK nail in SW side
- # 12 Power pole # ENF 79 S57W 54.85' set PK nail in NW side
- # 13 Standard Mason Co., Mon. West 9.26' (Cor. common to sec. 32 & 33 T18N, R16W)

Corner is approximately 6.5' E. of centerline of N. S. blacktop
and in centerline of blacktop west and gravel east.
Corner is in a monument box.

Signed by Sammy S. Barnett
Surveyor's Michigan License No. PS # 16923

Date 11-4-97

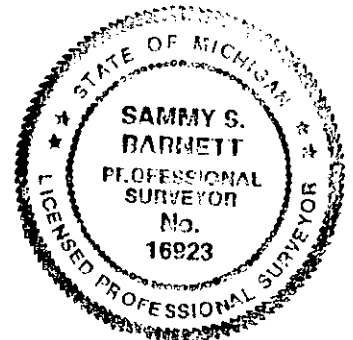

Reviewed
11/11/97
Date Oct 21 1997
Sammy S. Barnett
Counsellor L. Ross
Michigan County Surveyor