

COMMISSION

LAND CORNER RECORDATION CERTIFICATE
Filing Requirement of Act 74, Mich. P.A. 1970

FILED
AT 2:35 O'CLOCK P M
OCT 13 1993
MARY GOLDEN KOLASKI
MASON COUNTY
REGISTER OF DEEDS

For corners in

MASON (County) Located In: Corner Code # F-3 64
1. Public Land Survey T 17NR 16W
2. Property Controlling S T R
3. Miscellaneous S T R
Property in Sec. S T R

Register of Deeds Stamp & File Number

- 4. Lot No. Recorded Plat
5. Private Claims

Kenneth L. Ross, in a field survey on OCTOBER, 19 93, do hereby certify that under requirements of P.A. 74, Michigan P.A. of 1970, the corner points mentioned in lines 1 and 2 above were in conformance with regulations and rules therefore as required in the current manual of survey instructions of the United States Department of the Interior, Bureau of Land Management or by a decree of a Court of Law and/or that the corner points mentioned in lines 3, 4 and 5 above were in conformance with the rules of the Michigan Board of Land Surveyors or by a Decree of a Court of Law; established, re-established, monumented, re-monumented, recovered, found as expressed below:

Grid table with columns A-M and rows 2-13. Contains numerical data points for survey locations.

NOTE: Not more than 4 corners, all in the same town and range, may be recorded on this certificate.

A. Description of original monument and accessories and/or subsequent restoration:

- F-3 1/4 Corner, Secs. 4 & 9: 1838 John Hodgeson set Post, 10" Hemlock for corner, no witness.
G-4 1/4 Corner, Secs. 9 & 10: 1838 John Hodgeson set Post, 18" Beech S 63 E 27 lks, 17" Beech N 45 E 33 lks.

B. Description of corner evidence found and/or method applied in restoring or reestablishing corner:

- F-3 1/4 Corner, Secs. 4 & 9: Ross 1988 Fd 1/2" re-rod, 24" Maple S 50 W 59.35', 28" Tw. Maple S 05 W 60.93', 28" W. Oak N 50 E 33.85', Fence to South, Dist to NW cor = 2658.89', Dist to NE cor = 2666.17'.
G-4 1/4 Corner, Secs. 9 & 10: Ross 1973 Fd nail on E-W fence line no witness, Ross 1988 Fd 1/2" Iron on Pavement no witness.


C. Description of monument for corner and accessories established to perpetuate locating the position of the corner:

- F-3 1/4 Corner, Secs. 4 & 9: Found 1/2" re-bar w/large piece of flat iron next to it, in North 1/2 of dirt/gravel rd. Fd existing witness, replaced with 5/8" X 36" re-bar with 2 1/2" alum. cap set 0.8' below road surface 3' South of N. edge of road, and is accepted as the best available evidence of the original corner. 30" Maple N 07 W 66.66', 28" W. Oak N 53 E 33.66', 28" Tw. Maple S 14 W 60.88', 24" Maple S 53 W 59.29', Ross Cap Iron South 33.02'.
G-4 1/4 Corner, Secs. 9 & 10: Found 1/2" Iron rod in pavement, replaced with 5/8" X 24" re-bar with 2 1/2" alum. cap also placed monument box Iron set 0.3' below road surface in monument box, and is accepted as the best available evidence of the original corner. P. Pole N 80 W 39.24', P. Pole S 06 W 430.10', 30" W. Pine S 72 E 142.48', 4" J. Pine S 73 W 153.79'.

Signed by Kenneth L. Ross

Date 10-12-93

Surveyor's Michigan License No.

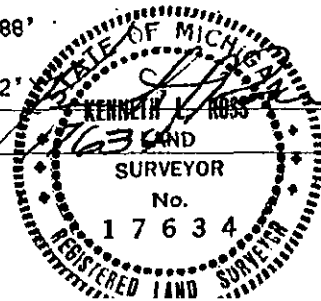

Peer Group Reviewed and Approved Date: 10-12-93 Kenneth L. Ross Mason County Surveyor