

**MAR 16 1998**


**LAND CORNER RECORDATION CERTIFICATE**

Filing Requirement of Act 74, Mich. P.A. 1970

**SECTION**  
For corners in  
MASON  
(County)

Located In:

Corner Code #

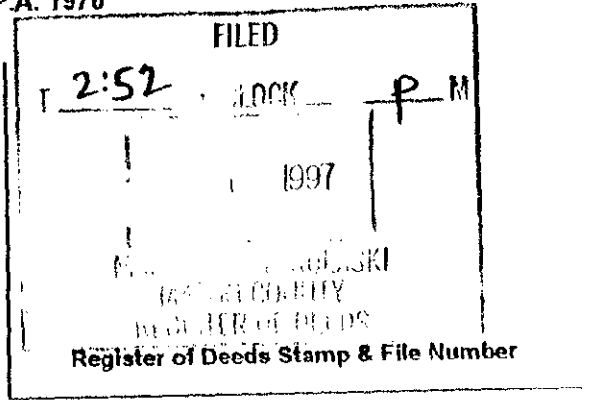

- 1. Public Land Survey T 17N R 16W G-07
- T R
- T R
- T R
- 2. Property Controlling S T R
- in Section S T R
- 3. Miscellaneous S T R
- Property in Sec. S T R
- 4. Lot No. \_\_\_\_\_ Recorded Plat \_\_\_\_\_
- 5. Private Claims \_\_\_\_\_

	A	B	C	D	E	F	G	H	I	J	K	L	M
1													
2	6	5	4	3	2	1							
3													
4	7	8	9	10	11	12							
5													
6	18	17	16	15	14	13							
7													
8	19	20	21	22	23	24							
9													
10	30	29	28	27	26	25							
11													
12	31	32	33	34	35	36							
13													

I, Kenneth L. Ross in a field survey on November 5, 1997, do hereby certify that under requirements of P.A. 74, Michigan P.A. of 1970, the corner points mentioned in lines 1 and 2 above were in conformance with regulations and rules therefore as required in the current manual of survey instructions of the United States Department of the Interior, Bureau of Land Management or by a decree of a Court of Law and/or that the corner points mentioned in lines 3, 4 and 5 above were in conformance with the rules of the Michigan Board of Land Surveyors or by a Decree of a Court of Law; established, re-established, monumented, re-monumented, recovered, found as expressed below:

**NOTE: Not more than 4 corners, all in the same town and range, may be recorded on this certificate.**

A. Description of original monument and accessories and/or subsequent restoration:  
G-07 Section Corner for Sections 15, 16, 21 and 22, T17N-R16W

1838, John Hodgson, G.L.O.  
Set Wood Post  
#1 Hemlock 8" N 57° W 21 lks. (13.86 ft.)  
#2 Cedar 14" S 77° E 14 lks. (9.24 ft.)

1990, Gordon Bonney, RLS #12016  
Found Iron in Monument Box in Survey  
Liber 391-Page 836

1889, W. E. Metcalf  
States corner O.K. in  
survey map Book 1, Page 215

B. Description of corner evidence found and/or method applied in restoring or reestablishing corner:  
G-07 Section Corner for Sections 15, 16, 21 and 22, T17N-R16W

On November 5, 1997, I Kenneth Ross and Kevin Pritchard (survey tech.) found a 3/4", 24" long, Iron Pipe inside a existing monument box at the intersection of Meisenheimer Road and Custer Road (paved). I found no evidence to dispute this location for the corner.

Condition of recorded witnesses are: #1 Gone #2 Gone

C. Description of monument for corner and accessories established to perpetuate locating the position of the corner:  
G-07 Section Corner for Sections 15, 16, 21 and 22, T17N-R16W

I replaced, in the exact location, 3/4" Iron Pipe, with a standard Mason County Monument (5/8" Re-rod, 24" long, with a 2 1/2" aluminum cap), placed in the existing monument box. and is accepted as a careful and faithful re-establishment of the position of the original corner.

Ext. "RP" Power Pole N 47° E 89.10 ft. (16p. nail in NW side of Pole)  
Tele-Junc. Box N 58° W 52.61 ft. (top center)  
Tele-Junc. Box S 40° E 42.30 ft. (top center)  
Stop Sign S 65° W 38.35 ft. (center of steel post)  
Measured distance to H-7 is 2633.03 ft. East.  
Measured distance to G-6 is 2626.48 ft. North.



Signed by [Signature] Date Nov 4 1997

Surveyor's Michigan License No. 17634

FORM APPROVED BY MICHIGAN STATE BOARD OF LAND SURVEYORS, JAN. 28, 1971  
REVISED MAY 14, 1975  
REVISED JAN. 1983  
ADAPTED FOR WORD PROCESSING MARCH, 1983