

**SURVEY &  
REMONUMENTATION**

MAR 16 1998

LIBER -- 4 PAGE 120

**LAND CORNER RECORDATION CERTIFICATE**

Filing Requirement of Act 74, Mich. P.A. 1970

**SECTION**

For corners in  
MASON  
(County)

Located In: \_\_\_\_\_ Corner Code # \_\_\_\_\_


1. Public Land Survey T 17N R 16 W H-1  
T \_\_\_\_\_ R \_\_\_\_\_  
T \_\_\_\_\_ R \_\_\_\_\_  
T \_\_\_\_\_ R \_\_\_\_\_

2. Property Controlling S \_\_\_\_\_ T \_\_\_\_\_ R \_\_\_\_\_  
in Section S \_\_\_\_\_ T \_\_\_\_\_ R \_\_\_\_\_

3. Miscellaneous S \_\_\_\_\_ T \_\_\_\_\_ R \_\_\_\_\_  
Property In Sec. S \_\_\_\_\_ T \_\_\_\_\_ R \_\_\_\_\_

4. Lot No. \_\_\_\_\_ Recorded Plat \_\_\_\_\_

5. Private Claims \_\_\_\_\_

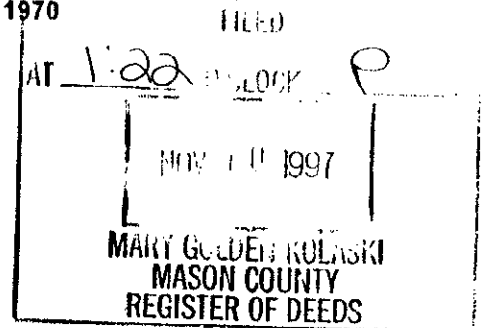

Register of Deeds Stamp & File Number

	A	B	C	D	E	F	G	H	I	J	K	L	M
1													
2	6		5		4		3		2		1		
3													
4	7		8		9		10		11		12		
5													
6	18		17		16		15		14		13		
7													
8	19		20		21		22		23		24		
9													
10	30		29		28		27		26		25		
11													
12	31		32		33		34		35		36		
13													

I, Sammy S. Barnett, in a field survey on Sept. 15th 19 97, do hereby certify that under requirements of P.A. 74, Michigan P.A. of 1970, the corner points mentioned in lines 1 and 2 above were in conformance with regulations and rules therefore as required in the current manual of survey instructions of the United States Department of the Interior, Bureau of Land Management or by a decree of a Court of Law and/or that the corner points mentioned in lines 3, 4 and 5 above were in conformance with the rules of the Michigan Board of Land Surveyors or by a Decree of a Court of Law; established, re-established, monumented, re-monumented, recovered, found as expressed below:

**NOTE: Not more than 4 corners, all in the same town and range, may be recorded on this certificate.**

**A. Description of original monument and accessories and/or subsequent restoration:**

H - 1 North one-quarter corner of section 3 T17, R16W

Not set by GLO survey 1896 petition survey by W.R. Metcalf  
Monument not given  
One-quarter corner established by measurement  
on line between one-quarter corner section 34  
and Northeast corner of section 3

1996 survey by S. Barnett set a 1/2" iron rod onehalf way between the Northeast and the Northwest corners of section 3 T17N, R16W and on line between the South onequarter corner and the Southeast corner of section 34 T18N, R16W # 1 South onequarter corner of section 34 West 6.93'

**B. Description of corner evidence found and/or method applied in restoring or reestablishing corner:**

H - 1 North one-quarter corner of section 3 T17, R16W

Not set by GLO survey

On Sept. 12th 1997 I found the 1/2" iron rod set by S. Barnett. the Condition of the witness is as follows,  
# 1 Found


**C. Description of monument for corner and accessories established to perpetuate locating the position of the corner:**

H - 1 North one-quarter corner of section 3 T17, R16W

On Sept. 12th 1997 I replaced the found 1/2" iron rod with a Standard Mason County Monument. This position not established by original government surveyors. This monument is accepted as the best available evidence of the position of the corner. I took the following witnesses,

- # 2 W. Cherry 6" S68E 25.81' 60d spike in N. side
- # 3 Maple 6" S88W 20.80' 60d spike in N. side
- # 4 Maple 14" N32W 56.32' 60d spike in NE side
- # 5 1/2" capped iron N51E 52.63' set old fence post alongside
- # 6 S 1/4 corner of section 34 T18N R16W West 6.93' Standard Mason Co., Mon. (# 1)

Monument falls at base of steep road cut  
Centerline of gravel road is North 13' + -

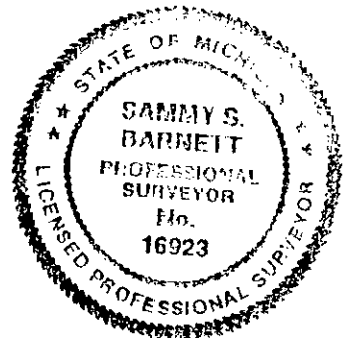

Signed by Sammy S. Barnett Date 11-4-97

Surveyor's Michigan License No. P S # 16923

Peer Group Reviewed  
and Approved  
Date: Oct 27 1997  
Kenneth L. Ross  
Mason County Surveyor