


**SURVEY & REMONUMENTATION**

MAR 16 1998

**LAND CORNER RECORDATION CERTIFICATE**

**SECTION**

Filing Requirement of Act 74, Mich. P.A. 1970

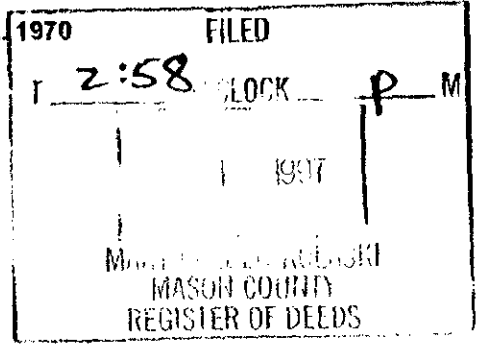

Register of Deeds Stamp & File Number

For corners in MASON Located In: \_\_\_\_\_ Corner Code # \_\_\_\_\_  
 (County)

1. Public Land Survey T 17N R 16W H-07  
 T R  
 T R  
 T R

2. Property Controlling S T R  
 in Section S T R

3. Miscellaneous S T R  
 Property in Sec. S T R

4. Lot No. \_\_\_\_\_ Recorded Plat \_\_\_\_\_  
 5. Private Claims \_\_\_\_\_

I, Kenneth L. Ross, in a field survey on November, 15 19 97, do hereby certify that under requirements of P.A. 74, Michigan P.A. of 1970, the corner points mentioned in lines 1 and 2 above were in conformance with regulations and rules therefore as required in the current manual of survey instructions of the United States Department of the Interior, Bureau of Land Management or by a decree of a Court of Law and/or that the corner points mentioned in lines 3, 4 and 5 above were in conformance with the rules of the Michigan Board of Land Surveyors or by a Decree of a Court of Law; established, re-established, monumented, re-monumented, recovered, found as expressed below:

**NOTE: Not more than 4 corners, all in the same town and range, may be recorded on this certificate.**

**A. Description of original monument and accessories and/or subsequent restoration:**

H-07 1/4 corner for Section 15 and 22, T17N-R16W.

1838, John Hodgson, G.L.O.  
 Set Wood Post

- #1 Hemlock 15" S 22° E 17 lks. (11.22ft.)
- #2 Hemlock 8" N 38° W 13 lks. ( 8.58ft.)

1990, Gordon Bonney, RLS# 12016

- Found "T" Iron
- #3 SW cor of house foundation N 44° E 116.12 ft.
- #4 Pine 8" North 33.08 ft.
- #5 Fence Post S 05° W 28.00 ft.

1889, W. E. Metcalf  
 Found Gov't witness trees

Book 1, page 215

1995, Ken Ross, RLS #17634  
 Found "T" Iron

- #6 Red Oak 5" N 38° W 36.30 ft.
- #7 Cedar 5" S 65° E 55.71 ft.
- #8 RR tie S 12° W 27.99 ft.
- #9 Red Oak 40" Red Oak S 85° W 126.52 ft.

**B. Description of corner evidence found and/or method applied in restoring or reestablishing corner:**

H-07 1/4 corner for Section 15 and 22, T17N-R16W.

On November 5, 1997, I Kenneth Ross and Kevin Pritchard (survey tech.) found a "T" Iron next to a 1/2 x 36" long lead pipe, markers are 2.0 feet North of the center-line of Heiseheimer Road (gravel), just below road surface. I found no evidence to dispute this location for the corner.

Condition of recorded witnesses are: #1 Gone #2 Gone #3 Found in good condition

- #4 Found in good condition #5 Found in good condition #6 Found in good condition #7 Found in good condition
- #8 Same as 5 #9 Found in good condition

**C. Description of monument for corner and accessories established to perpetuate locating the position of the corner:**

H-07 1/4 corner for Section 15 and 22, T17N-R16W.

I replace "T" Iron, in the exact location with a standard Mason County Monument (5/8" id-rod, 24" long, with a 2 1/2" aluminum cap, stamped to identify the corner. Re-rod was set 0.5 feet below the gravel road. And is accepted as a careful and faithful re-establishment of the position of the original corner.

- Ext "BT" #4 Red Pine 10" North 33.08 ft. (Ext. 16p. nail on west side of tree)
- Ext "BT" #6 Red Oak 5" N 87° W 36.30 ft. (Ext. 60d spike on SW side of tree)
- Ext "BT" #7 Cedar 6" S 65° E 55.71 ft. (Ext. 60d spike in NE side of tree)
- Ext "BT" #9 Red Oak 40" S 85° W 126.52 ft. (Ext. 60d spike in NW side of tree)

*Ken Ross*  
 Mason County

Signed by *Ken Ross*

Date Nov. 6, 1997

Surveyor's Michigan License No. 17634