

SURVEY & REMONUMENTATION

MAR 16 1998


LIBER -- 4 PAGE 119

LAND CORNER RECORDATION CERTIFICATE

Filing Requirement of Act 74, Mich. P.A. 1970

SECTION

For corners in	Located In:	Corner Code #
<u>MASON</u>		
(County)		
1. Public Land Survey	T 17 N R 16 W	1-1
	T _____ R _____	_____
	T _____ R _____	_____
	T _____ R _____	_____
2. Property Controlling in Section	S _____ T _____ R _____	_____
	S _____ T _____ R _____	_____
3. Miscellaneous Property in Sec.	S _____ T _____ R _____	_____
	S _____ T _____ R _____	_____

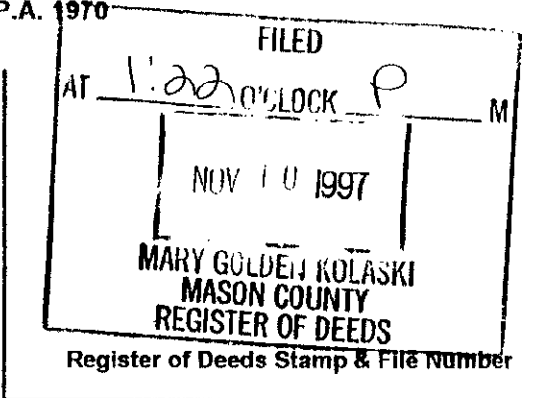

4. Lot No. _____, Recorded Plat _____
 5. Private Claims _____

I, Sammy S. Barnett, in a field survey on Sept. 12th 19 97, do hereby certify that under requirements of P.A. 74, Michigan P.A. of 1970, the corner points mentioned in lines 1 and 2 above were in conformance with regulations and rules therefore as required in the current manual of survey instructions of the United States Department of the Interior, Bureau of Land Management or by a decree of a Court of Law and/or that the corner points mentioned in lines 3, 4 and 5 above were in conformance with the rules of the Michigan Board of Land Surveyors or by a Decree of a Court of Law; established, re-established, monumented, re-monumented, recovered, found as expressed below:

NOTE: Not more than 4 corners, all in the same town and range, may be recorded on this certificate.

	A	B	C	D	E	F	G	H	I	J	K	L	M
1													
2	6		5		4		3		2		1		
3													
4	7		8		9		10		11		12		
5													
6	18		17		16		15		14		13		
7													
8	19		20		21		22		23		24		
9													
10	30		29		28		27		26		25		
11													
12	31		32		33		34		35		36		
13													

A. Description of original monument and accessories and/or subsequent restoration:

I - 1 Corner common to sections 2 and 3 T17N, R16W

1838 GLO survey by Mullett & Brookfiels
 Boundary 11 lks (7.26') East of post
 Set post at intersection
 # 1 Beech 14" S66W 33 lks (21.78')
 # 2 Beech 8" S63E 18 lks (11.88')

1896 survey by W. E. Metcalf, set this corner
 11 lks (7.26') East of found evidence of the old
 government witnesses for section 34,35.
 # 3 Pine stump 30 S60E 49 lks (32.34')
 # 4 Pine stump 18 S37E 78 lks (51.48')

1996 survey by S. Barnett found stone set 1/2" rebar
 # 5 1/2" capped rebar West 7.26' (Corner common to
 Sections ~~34~~ & ~~35~~ T18N R16W)
 34 35

B. Description of corner evidence found and/or method applied in restoring or reestablishing corner:

I - 1 Corner common to sections 2 and 3 T17N, R16W


On Sept 12th 1997 I found the 1/2" rebar as set by S. Barnett, the condition of the witnesses are as follows,
 # 1 Gone # 2 Gone # 3 Gone # 4 Gone # 5 Found

C. Description of monument for corner and accessories established to perpetuate locating the position of the corner:

I - 1 Corner common to sections 2 and 3 T17N, R16W

On Sept 12th 1997, I replaced the found 1/2" rebar with a Standard Mason County Monument and accepted this location as a careful and faithful reestablishment of the position of the original corner, and took the following witnesses.

- # 6 Spruce 6" N50E 48.10' 60d spike in NW side
- # 7 1/2" iron South 33'
- # 8 Ash 4" S48W 38.21' 60d spike in SE side
- # 9 Beech 16" N33W 62.12' 60d spike in SW side
- # 10 Standard Mason Co. Mon. West 7.26' (corner common to sec. 34 & 35 T18N R16W) (# 5)

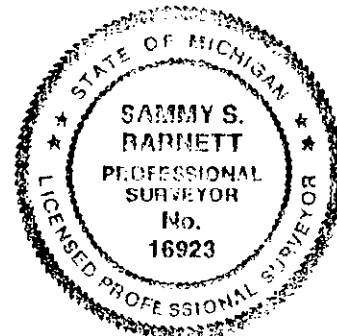

Signed by Sammy S. Barnett Date 11-4-97
 Surveyor's Michigan License No. P S # 16923

Peer Group Reviewed and Approved
 Date Oct 2, 1997
Kenneth L. Ross
 Mason County Surveyor