

MAR 16 1998

SECTION

LAND CORNER RECORDATION CERTIFICATE

Filing Requirement of Act 74, Mich. P.A. 1970

FILED


For corners in
MASON
 (County)

Located In: _____ Corner Code # _____

1. Public Land Survey T 17 N R 16 W J-1
 T _____ R _____
 T _____ R _____
 T _____ R _____

2. Property Controlling S _____ T _____ R _____
 in Section S _____ T _____ R _____

3. Miscellaneous S _____ T _____ R _____
 Property in Sec. S _____ T _____ R _____

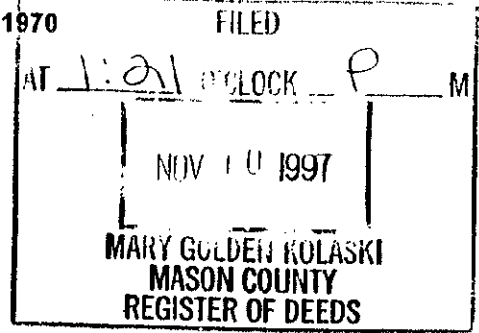

Register of Deeds Stamp & File Number

4. Lot No. _____, Recorded Plat _____
 5. Private Claims _____

	A	B	C	D	E	F	G	H	I	J	K	L	M
1													
2	6	5	4	3	2	1							
3													
4	7	8	9	10	11	12							
5													
6	18	17	16	15	14	13							
7													
8	19	20	21	22	23	24							
9													
10	30	29	28	27	26	25							
11													
12	31	32	33	34	35	36							
13													

I, Sammy S. Barnett, in a field survey on Sept. 12th 19 97, do hereby certify that under requirements of P.A. 74, Michigan P.A. of 1970, the corner points mentioned in lines 1 and 2 above were in conformance with regulations and rules therefore as required in the current manual of survey instructions of the United States Department of the Interior, Bureau of Land Management or by a decree of a Court of Law and/or that the corner points mentioned in lines 3, 4 and 5 above were in conformance with the rules of the Michigan Board of Land Surveyors or by a Decree of a Court of Law; established, re-established, monumented, re-monumented, recovered, found as expressed below:

NOTE: Not more than 4 corners, all in the same town and range, may be recorded on this certificate.

A. Description of original monument and accessories and/or subsequent restoration:

J -1 North one-quarter corner, section 2 T17N, R16W
 Not set by GLO survey

1996 survey by S. Barnett set a 1/2" iron rod onehalf way between the Northeast and the Northwest corners of section 2 T17N, R16W and on line between the South onequarter corner and the Southeast corner of section 35 T18N, R16W
 # 1 South onequarter corner of section 35 West 1.70'

B. Description of corner evidence found and/or method applied in restoring or reestablishing corner:

J -1 North one-quarter corner, section 2 T17N, R16W
 Not set by GLO survey


On Sept. 12th 1997, I found the 1/2" iron rod set by S. Barnett in 1996, the condition of the witness is as follows.
 # 1 Found

C. Description of monument for corner and accessories established to perpetuate locating the position of the corner:

J -1 North one-quarter corner, section 2 T17N, R16W
 Not set by GLO survey

On Sept. 12th 1997 I replaced the found 1/2" iron rod with a Standard Mason County Monument. This position not established by original government surveyors. This monument is accepted as the best available evidence of the position of the corner. I took the following witnesses,

- # 2 White Pine 6" N51W 21.80' 60d spike in SW side
 - # 3 Oak 8" N12E 25.02' 60 d spike in W. side
 - # 4 White Pine 6" S10E 16.09' 60 d spike in SW side
 - # 5 White Pine 8" S51W 19.76' 60 d spike in SE side
 - # 6 Standard Mason County Monument West 1.70'
- Dirt/gravel road South 90' + -

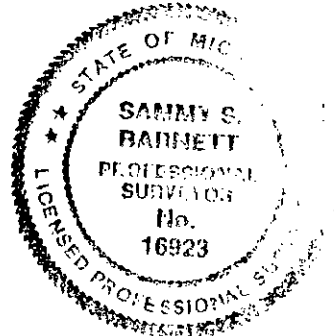

Signed by Sammy S. Barnett Date 11-4-97
 Surveyor's Michigan License No. PS # 16923

Peer Group Reviewed
 and Approved
 Date: Oct 2, 1997
Kenneth L. Ross
 Mason County Surveyor