

SURVEY &
RECORDATION

DEC 18 1995

COMMISSION

LAND CORNER RECORDATION CERTIFICATE
Filing Requirement of Act 74, Mich. P.A. 1970

For corners in

MASON (County) Located In: _____; Corner Code ##


1. Public Land Survey T 17 N R 16 W K-1
 T _____ R _____
 T _____ R _____
 T _____ R _____

2. Property Controlling S _____ T _____ R _____
 in Section S _____ T _____ R _____

3. Miscellaneous S _____ T _____ R _____
 Property in Sec. S _____ T _____ R _____

4. Lot No. _____, Recorded Plat _____

5. Private Claims _____

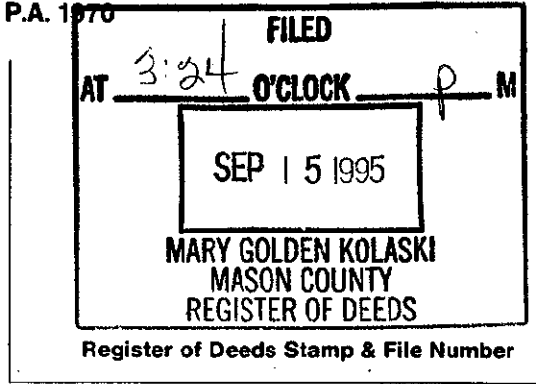

	A	B	C	D	E	F	G	H	I	J	K	L	M
2	6	5	4	3	2	1							
3													
4	7	8	9	10	11	12							
5													
6	18	17	16	15	14	13							
7													
8	19	20	21	22	23	24							
9													
10	30	29	28	27	26	25							
11													
12	31	32	33	34	35	36							
13													

I, Sammy S. Barnett, in a field survey on _____, 19 95, do hereby certify that under requirements of P.A. 74, Michigan P.A. of 1970, the corner points mentioned in lines 1 and 2 above were in conformance with regulations and rules therefore as required in the current manual of survey instructions of the United States Department of the Interior, Bureau of Land Management or by a decree of a Court of Law and/or that the corner points mentioned in lines 3, 4 and 5 above were in conformance with the rules of the Michigan Board of Land Surveyors or by a Decree of a Court of Law; established, re-established, monumented, re-monumented, recovered, found as expressed below:

NOTE: Not more than 4 corners, all in the same town and range, may be recorded on this certificate.

A. Description of original monument and accessories and/or subsequent restoration:
 K-1 Section Corner for Section 1 and 2, T17N, R16W., on the Township line.

- | | |
|---|---|
| <u>1838, John Hodgson, D.S., G.L.O.</u>
Set Wood Post 251ks. East of Boundary Corner | <u>1994, Ken Ross, M.C.S., (R. Hepworth)</u>
Set 1/2" Re-Rod |
| #1 Beech 10" S 55° E 181ks.(11.88') | #3 Poplar 8" N 24° W 10.33' |
| #2 Beech 6" S 50° E 181ks.(11.88') | #4 Cherry 5" S 24° E 25.84' |

B. Description of corner evidence found and/or method applied in restoring or reestablishing corner:

K-1 Section Corner for Section 1 and 2, T17N, R16W, on the Township Line.

On August 9, 1995, I found a 1/2" Re-Rod with Ross Survey P.S. cap, 100 feet South of Chauvez Road, I search the area for other Irons or Markers or old Witness trees but found none.

Condition of Recorded Witnesses is ; #1 Gone #2 Gone #3 Found in good cond. #4 Found in good cond.

C. Description of monument for corner and accessories established to perpetuate locating the position of the corner:


K-1 Section corner for Section 1 and 2, T17N, R16W, on the Township Line.

I replaced 1/2" Re-Rod with a 5/8" Re-Rod, 24" long with an aluminum cap stamped MASON COUNTY MONUMENT, placed flush with the ground surface, and is accepted as a careful and faithful reestablishment of the position of the original corner.

- OBT #3 Poplar 7" N 24° W 10.33' (60d spike in SW side of tree)
 OBT #4 Cherry 5" S 24° E 25.84' (60d spike in SW side of tree)
 Red Oak 9" N 52° E 56.53' (60d spike in SE side of tree)
 MASON COUNTY Monument (aluminum cap) West ~~16.50'~~ 16.50'

Signed by Sammy S. Barnett Date 9-8-95

Surveyor's Michigan License No. 16923
 Peer Group Reviewed and Approved [Signature] Date: 9-12-95
Kenneth L. Ross
 Mason County Surveyor

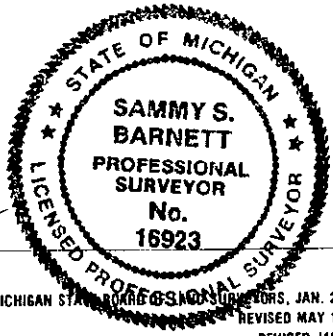

LIBER 3 PAGE 277