

SURVEY & REMONUMENTATION

APR 28 1995

COMMISSION

LAND CORNER RECORDATION CERTIFICATE
Filing Requirement of Act 74, Mich. P.A. 1970


For corners in

Located In: _____ Corner Code # _____

1. Public Land Survey T 17N R 16W K-2
T _____ R _____
T _____ R _____
T _____ R _____

2. Property Controlling S _____ T _____ R _____
in Section S _____ T _____ R _____

3. Miscellaneous S _____ T _____ R _____
Property in Sec. S _____ T _____ R _____

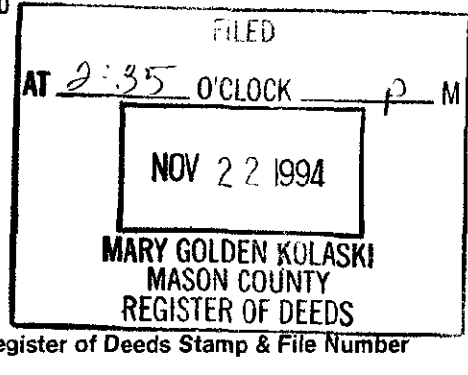

4. Lot No. _____, Recorded Plat _____
5. Private Claims _____

I, Theodore H. Weinert, in a field survey on OCTOBER, 1994, do hereby certify that under requirements of P.A. 74, Michigan P.A. of 1970, the corner points mentioned in lines 1 and 2 above were in conformance with regulations and rules therefore as required in the current manual of survey instructions of the United States Department of the Interior, Bureau of Land Management or by a decree of a Court of Law and/or that the corner points mentioned in lines 3, 4 and 5 above were in conformance with the rules of the Michigan Board of Land Surveyors or by a Decree of a Court of Law; established, re-established, monumented, re-monumented, recovered, found as expressed below:

NOTE: Not more than 4 corners, all in the same town and range, may be recorded on this certificate.

A. Description of original monument and accessories and/or subsequent restoration:

K-2 1/4 Corner, Secs. 1 & 2
G.L.O. Notes Set Post
July, 1838, John Hodgson
8" Maple S 17 W 22 lks
8" Maple N 30 E 5 lks
Undated, Unsigned survey Book 1, Page 66, Mason County Records

*Survey by Stephens, B.L.S.
MAY, 1959.
Cone Mon by Stephens
North, 389.80 feet*

B. Description of corner evidence found and/or method applied in restoring or reestablishing corner:

K-2 1/4 Corner, Secs. 1 & 2
No corner evidence found.
Fence line north and south.
Set corner on prorated distance with G.L.O. Notes
0.5' East of north-south fence line.
SW corner bears S 00-09-28 W 2608.81'
NW corner bears N 00-17-39 W 2732.40'

C. Description of monument for corner and accessories established to perpetuate locating the position of the corner:

K-2 1/4 Corner, Secs. 1 & 2
Set 5/8" X 36" rebar with standard 2 1/2" cap stamped "Mason County Remonumentation".
36" DbI. Maple S 60 W 22.80'
24" W. Oak N 11 W 57.67'
20" R. Oak N 46 E 48.89'
18" W. Pine S 65 E 18.91'
12" W. Oak S 12 E 61.05'
CL Two Track West 6.0'
Single Strand North-South Fence East 0.5'



Signed by Theodore H. Weinert
Surveyor's Michigan License No. 19846

Date 11-6-94

Peer Group Reviewed
FORM APPROVED BY MICHIGAN STATE BOARD OF LAND SURVEYORS, JAN. 28, 1971
REVISOR MAY 14, 1975
REVISOR JAN., 1983
Date: 11-5-94
Kenneth L. Ross
Mason County Surveyor