SURVEY &
REMONUMENTATION

MAR 0 8 1994

COMMISSION

LAND CORNER RECORDATION CERTIFICATE

Filing Requirement of Act 74, Mich. P.A. 1970

For corners in

Mason (County)

	Located In:	Corner Code ##
1. Public Land Survey	T 17N R 16W	K-4
	T ___ R ___	
	T ___ R ___	
	T ___ R ___	
2. Property Controlling	S ___ T ___ R ___	
in Section	S ___ T ___ R ___	
3. Miscellaneous	S ___ T ___ R ___	
Property in Sec.	S ___ T ___ R ___	

FILED
AT 11 O'CLOCK a M
NOV 1 1993
MARY GOLDEN KOLASKI
MASON COUNTY
REGISTER OF DEEDS

Register of Deeds Stamp & File Number

4. Lot No. _____ , Recorded Plat _____
5. Private Claims _____

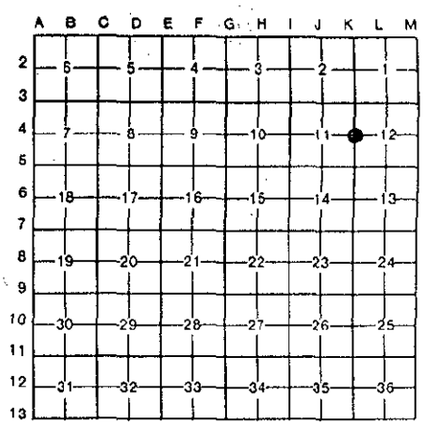

I, Richard Hays, in a field survey on October 27, 19 93, do hereby certify that under requirements of P.A. 74, Michigan P.A. of 1970, the corner points mentioned in lines 1 and 2 above were in conformance with regulations and rules therefore as required in the current manual of survey instructions of the United States Department of the Interior, Bureau of Land Management or by a decree of a Court of Law and/or that the corner points mentioned in lines 3, 4 and 5 above were in conformance with the rules of the Michigan Board of Land Surveyors or by a Decree of a Court of Law; established, re-established, monumented, re-monumented, recovered, found as *expressed below:*

NOTE: Not more than 4 corners, all in the same town and range, may be recorded on this certificate.

A. Description of original monument and accessories and/or subsequent restoration:

K-4 1/4 CORNER COMMON TO SECTIONS 11 & 12

1838 G.L.O. Set Post
18" Pine S-49°-W 10 Links
8" B. Oak N-42°-W 17 Links

1989 J. Randolph Hepworth set 3/4" x 2" Pipe at old fence corner.(Fence lines run North, South & West) (L.C.R.C. Liber 3, Page 33.)

24" W. Oak 310° Az 25.11'
8" R. Pine 215° Az 17.61'
4" W. Cherry 183° Az 31.25'
6" W. Oak 102° Az 71.05'

B. Description of corner evidence found and/or method applied in restoring or reestablishing corner:

K-4 1/4 CORNER COMMON TO SECTIONS 11 & 12

1993 Found 3/4" Pipe set by J. Randolph Hepworth (L.C.R.C. Liber 3, Page 33.)

24" W. Oak N-50°-W 25.12'
9" R. Pine S-40°-W 17.65'
Tw. 6" W. Cherry S-08°-W 31.28'

C. Description of monument for corner and accessories established to perpetuate locating the position of the corner:

K-4 1/4 CORNER COMMON TO SECTIONS 11 & 12

Replaced found 3/4" Pipe with Mason County Monument with 5/8" Re-Rod with cap stamped to identify Corner. This Monument is accepted as the best available evidence of the position of the Corner.

30" W. Oak N-50°-W 25.12'
9" R. Pine S-40°-W 17.65'
Tw. 6" W. Cherry S-08°-W 31.28'
10" W. Oak N-58°-E 71.65'

Corner is at the Northeast corner of a Pine Plantation

STATE OF MICHIGAN
RICHARD L. HAYS
LAND SURVEYOR
NO. 25847
REGISTERED

Signed by Richard Hays Date November 2, 1993

Surveyor's Michigan License No. 25847

FORM APPROVED BY MICHIGAN STATE BOARD OF LAND SURVEYORS, JAN. 28, 1971
REVISED MAY 14, 1975
REVISED JAN., 1983