

**SURVEY &
REMONUMENTATION**

MAR 08 1994

COMMISSION

LAND CORNER RECORDATION CERTIFICATE

Filing Requirement of Act 74, Mich. P.A. 1970


For corners in

Mason
(County)

Located In:

Corner Code #/

- | | | |
|------------------------------------|---------------------------|------------|
| 1. Public Land Survey | T <u>17N</u> R <u>16W</u> | <u>K-5</u> |
| | T _____ R _____ | _____ |
| | T _____ R _____ | _____ |
| | T _____ R _____ | _____ |
| 2. Property Controlling in Section | S _____ T _____ R _____ | _____ |
| | S _____ T _____ R _____ | _____ |
| 3. Miscellaneous Property in Sec. | S _____ T _____ R _____ | _____ |
| | S _____ T _____ R _____ | _____ |

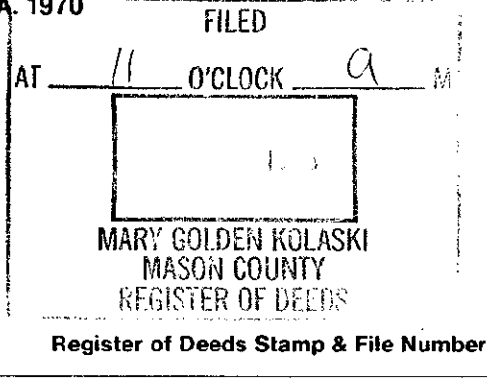

4. Lot No. _____, Recorded Plat _____
5. Private Claims _____

A	B	C	D	E	F	G	H	I	J	K	L	M
2	6	5	4	3	2	1						
3												
4	7	8	9	10	11	12						
5												
6	18	17	16	15	14	13						
7												
8	19	20	21	22	23	24						
9												
10	30	29	28	27	26	25						
11												
12	31	32	33	34	35	36						
13												

I, Richard Hays, in a field survey on October 27, 1993, do hereby certify that under requirements of P.A. 74, Michigan P.A. of 1970, the corner points mentioned in lines 1 and 2 above were in conformance with regulations and rules therefore as required in the current manual of survey instructions of the United States Department of the Interior, Bureau of Land Management or by a decree of a Court of Law and/or that the corner points mentioned in lines 3, 4 and 5 above were in conformance with the rules of the Michigan Board of Land Surveyors or by a Decree of a Court of Law; established, re-established, monumented, re-monumented, recovered, found as expressed below:

NOTE: Not more than 4 corners, all in the same town and range, may be recorded on this certificate.

A. Description of original monument and accessories and/or subsequent restoration:

K-5 SECTION CORNER COMMON TO SECTIONS 11,12,13, & 14		
1838, G.L.O. Set Post	1876 Survey by J.A. Mitchell	1989 J. Randolph Hepworth
16" Pine S-48°-W 18 Links	Survey South Line, 39.26 ch.	Set Corner on East and West
8" Pine N-46°-E 29 Links	from the South 1/4 Corner to	Fence Line of Mitchell
	the Southwest Corner Corner.	Distance (L.C.R.C. Liber 3,
	Corner identified from G.L.O.	Pg 32.)
	Witness Trees.	16" W. Oak 314° Az 17.37'
		18" R. Pine 188° Az 30.97'
		3" R. Pine 123° Az 16.88'
		3" B. Oak 14° Az 3.08'

B. Description of corner evidence found and/or method applied in restoring or reestablishing corner:

K-5 SECTION CORNER COMMON TO SECTIONS 11,12,13, & 14
 1993 Found 5/8" Re-Rod set by J. Randolph Hepworth (L.C.R.C. Liber 3, pg. 32)
 18" R. Pine S-17°-W 30.97'
 4" R. Pine S-54°-E 16.88'
 14" W. Oak N-45°-W 17.33'

C. Description of monument for corner and accessories established to perpetuate locating the position of the corner:

K-5 SECTION CORNER COMMON TO SECTIONS 11,12,13, & 14
 Placed Mason County Cap on 5/8" Re-Rod stamped to identify Corner. This Monument is accepted as the best available evidence of the position of the Corner.

28" White Oak	S-58°-W	91.68'
18" Red Pine	S-17°-W	30.97'
4" Red Pine	S-54°-E	16.88'
14" White Oak	N-45°-W	17.33'

Corner is on Old Fence Line (East and West)



Signed by Richard Hays Peer Group Review Date November 2, 1993

Surveyor's Michigan License No. 25847 Date: 11-9-93
 Kenneth L. Poss
 Mason County Surveyor