

MAR 16 1998

SECTION

LIBER -- 4 PAGE 117

LAND CORNER RECORDATION CERTIFICATE

Filing Requirement of Act 74, Mich. P.A. 1970

For corners in


MASON

(County)

Located In:

Corner Code #

- 1. Public Land Survey T 17 N R 16 W L-1
- T R
- T R
- T R
- 2. Property Controlling S T R
- in Section S T R
- 3. Miscellaneous S T R
- Property in Sec. S T R

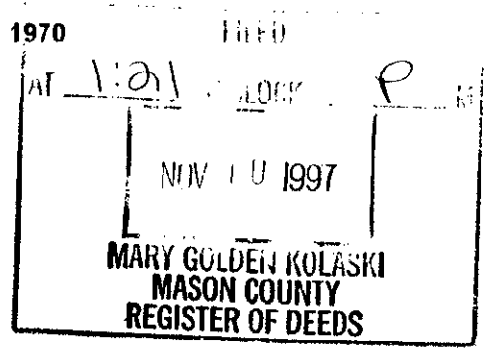

Register of Deeds Stamp & File Number

- 4. Lot No. \_\_\_\_\_, Recorded Plat \_\_\_\_\_
- 5. Private Claims \_\_\_\_\_

I, Sammy S. Barnett, in a field survey on Sept. 12 19 97, do hereby certify that under requirements of P.A. 74, Michigan P.A. of 1970, the corner points mentioned in lines 1 and 2 above were in conformance with regulations and rules therefore as required in the current manual of survey instructions of the United States Department of the Interior, Bureau of Land Management or by a decree of a Court of Law and/or that the corner points mentioned in lines 3, 4 and 5 above were in conformance with the rules of the Michigan Board of Land Surveyors or by a Decree of a Court of Law; established, re-established, monumented, re-monumented, recovered, found as expressed below:

NOTE: Not more than 4 corners, all in the same town and range, may be recorded on this certificate.

1	A	B	C	D	E	F	G	H	I	J	K	L	M
2		6	5	4	3	2	1						
3													
4		7	8	9	10	11	12						
5													
6		18	17	16	15	14	13						
7													
8		19	20	21	22	23	24						
9													
10		30	29	28	27	26	25						
11													
12		31	32	33	34	35	36						
13													

A. Description of original monument and accessories and/or subsequent restoration:

L -1 North one-quarter corner, section 1 T17N, R16W

Not set by GLO survey

1994 survey by K. Ross, set 1/2" iron rod

# 1 1/2" IR. West 8.25"

E-W trail road is South 50'

B. Description of corner evidence found and/or method applied in restoring or reestablishing corner:

L -1 North one-quarter corner, section 1 T17N, R16W

On Sept 12th 1997, I found the 1/2" iron rod set by K. Ross, the condition of the witnesses are as follows,

# 1 Found

C. Description of monument for corner and accessories established to perpetuate locating the position of the corner:

L -1 North one-quarter corner, section 1 T17N, R16W

On Sept. 12th 1997 I replaced the found 1/2" iron rod with a Standard Mason County Monument. This position not established by original government surveyors. This monument is accepted as the best available evidence of the position of the corner. I took the following witnesses,

- # 2 W. Oak 36" North 2.91' 60d spike in East side
- # 3 Cherry 10" S14E 23.97' 60d spike in West side
- # 4 Cherry 6" N41W 33.25' 60 d spike in Southwest side
- # 5 Standard Mason County Monument West 8.25' (# 1)

East-West trail road is South 50' + -

Signed by Sammy S. Barnett

Date 11-4-97

Surveyor's Michigan License No. P S # 16923



Peer Group Reviewed and Approved  
 Date: Oct 21 1997  
Kenneth L. Ross  
 Mason County Surveyor

LIBER 4 PAGE 117