

SURVEY & REMONUMENTATION

MAR 16 1998

SECTION

LAND CORNER RECORDATION CERTIFICATE
Filing Requirement of Act 74, Mich. P.A. 1970

For corners in

MASON (County) Located In: Corner Code #


1. Public Land Survey T 17N R 16W L-3
 T _____ R _____
 T _____ R _____
 T _____ R _____
 T _____ R _____

2. Property Controlling S _____ T _____ R _____
 In Section S _____ T _____ R _____

3. Miscellaneous S _____ T _____ R _____
 Property in Sec. S _____ T _____ R _____

4. Lot No. _____, Recorded Plat _____

5. Private Claims _____

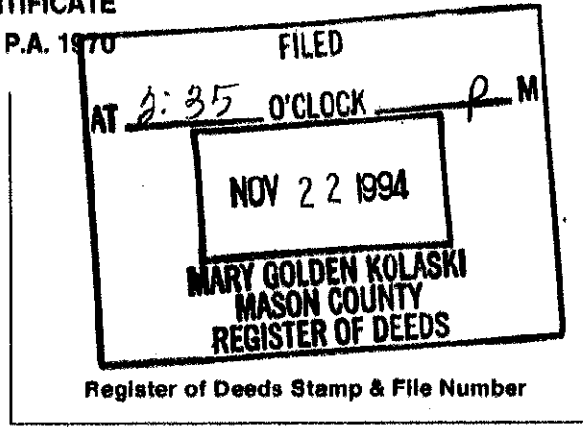

I, Theodore H. Weinert, in a field survey on OCTOBER, 1994, do hereby certify that under requirements of P.A. 74, Michigan P.A. of 1970, the corner points mentioned in lines 1 and 2 above were in conformance with regulations and rules therefore as required in the current manual of survey instructions of the United States Department of the Interior, Bureau of Land Management or by a decree of a Court of Law and/or that the corner points mentioned in lines 3, 4 and 5 above were in conformance with the rules of the Michigan Board of Land Surveyors or by a Decree of a Court of Law; established, re-established, monumented, re-monumented, recovered, found as expressed below:

NOTE: Not more than 4 corners, all in the same town and range, may be recorded on this certificate.


A. Description of original monument and accessories and/or subsequent restoration:
 L-3 1/4 Corner, Secs. 1 & 12
 G.L.O. Notes Set Post
 July, 1838, John Hodgson
 12" Pine S 65 W 34 lks
 12" Pine N 60 E 23 lks
 Undated, Unsigned survey Book 1, Page 66, Mason County Records

B. Description of corner evidence found and/or method applied in restoring or reestablishing corner:
 L-3 1/4 Corner, Secs. 1 & 12
 No corner evidence found.
 Set corner on prorated distance between SW corner and SE corner of section as per G.L.O.
 SW corner bears N 87-20-37 W 2559.58' and
 SE corner bears S 87-20-37 W 2559.58'
 G.L.O. Notes distance was recorded as 2633.40'
 73.82' short of G.L.O. each way
 This corner location is accepted as a careful and faithful perpetuation of the original corner.

C. Description of monument for corner and accessories established to perpetuate locating the position of the corner:
 L-3 1/4 Corner, Secs. 1 & 12
 Set 5/8" X 36" rerod with standard 2 1/2" cap stamped "Mason County Remonumentation".
 10" W. Pine N 15 E 19.10'
 6" W. Oak S 74 E 54.88'
 6" W. Oak S 07 W 38.71'
 13" W. Oak S 39 W 40.35'
 12" W. Oak S 68 W 32.70'

	A	B	C	D	E	F	G	H	I	J	K	L	M
2	6		5		4		3		2				
3													
4	7		6		9		10		11		12		
5													
6	18		17		16		15		14		13		
7													
8	19		20		21		22		23		24		
9													
10	30		29		28		27		26		25		
11													
12	31		32		33		34		35		36		
13													

Signed by Theodore H. Weinert Date 11/6/94
 Surveyor's Michigan License No. 19846

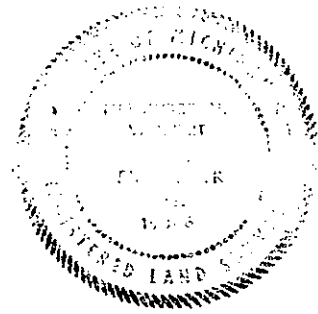

Peer Group Reviewed and Approved
 Date: 11/6/94
 Kenneth L. Röss
 Mason County Surveyor

