

SURVEY &
RECORDATION

MAR 08 1994

COMMISSION

LAND CORNER RECORDATION CERTIFICATE

Filing Requirement of Act 74, Mich. P.A. 1970

For corners in


Mason

(County)

Located In:

Corner Code #

- | | | |
|------------------------------------|-------------------------|-------|
| 1. Public Land Survey | T 17N R 16W | L-5 |
| | T _____ R _____ | _____ |
| | T _____ R _____ | _____ |
| | T _____ R _____ | _____ |
| 2. Property Controlling in Section | S _____ T _____ R _____ | _____ |
| | S _____ T _____ R _____ | _____ |
| 3. Miscellaneous Property in Sec. | S _____ T _____ R _____ | _____ |
| | S _____ T _____ R _____ | _____ |

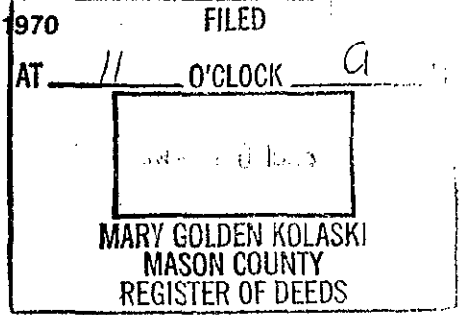

Register of Deeds Stamp & File Number

4. Lot No. _____, Recorded Plat _____
5. Private Claims _____

	A	B	C	D	E	F	G	H	I	J	K	L	M
2	6	5	4	3	2	1							
3													
4	7	8	9	10	11	12							
5													
6	18	17	16	15	14	13							
7													
8	19	20	21	22	23	24							
9													
10	30	29	28	27	26	25							
11													
12	31	32	33	34	35	36							
13													

I, Richard Hays, in a field survey on October 27, 1993, do hereby certify that under requirements of P.A. 74, Michigan P.A. of 1970, the corner points mentioned in lines 1 and 2 above were in conformance with regulations and rules therefore as required in the current manual of survey instructions of the United States Department of the Interior, Bureau of Land Management or by a decree of a Court of Law and/or that the corner points mentioned in lines 3, 4 and 5 above were in conformance with the rules of the Michigan Board of Land Surveyors or by a Decree of a Court of Law; established, re-established, monumented, re-monumented, recovered, found as expressed below:

NOTE: Not more than 4 corners, all in the same town and range, may be recorded on this certificate.

A. Description of original monument and accessories and/or subsequent restoration:

- L-5 1/4 CORNER COMMON TO SECTIONS 12 & 13
 1838 G.L.O. Set Post
 8" Beech N-39°-E 29 Links
 8" Beech S-23°-W 35 Links
 1989, J.Randolph Hepworth set 1/2" Pipe.
 (L.C.R.C. Liber 3, Pg 32)
 12" B. Oak 41° Az 43.21'
 12" W. Oak 03° Az 61.01'
 6" B. Oak 304° Az 17.73'
 6" W. Oak 129° Az 45.73'


B. Description of corner evidence found and/or method applied in restoring or reestablishing corner:

- L-5 1/4 CORNER COMMON TO SECTIONS 12 & 13
 1993 Found 1/2" Iron Pipe set by J. Randolph Hepworth (L.C.R.C. Liber 3, Page 32)
 6" W. Oak N-50°-W 17.78'
 8" W. Oak S-50°-E 45.70'
 12" W. Oak N-42°-E 43.22'
 Tw. 9" & 6" W. Oak N-04°-E 61.08'

C. Description of monument for corner and accessories established to perpetuate locating the position of the corner:

- L-5 1/4 CORNER COMMON TO SECTIONS 12 & 13
 Replaced 1/2" Iron Pipe with a Mason County Monument 5/8" Re-Rod with cap stamped to identify corner. this monument is accepted as the best available evidence of the position of the Corner.
 11" B. Oak S-42°-W 54.37'
 8" W. Oak S-50°-E 45.70'
 14" W. Oak N-42°-E 43.22'
 Tw. 9" & 6" W. Oak N-04°-E 61.08'
 6" B. Oak N-50°-W 17.78'

Centerline of Trail is 12' East and Fence Corner is 2' Southwest of Corner

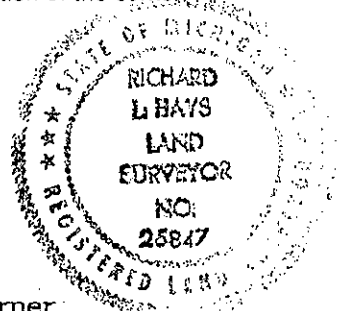

Signed by Richard Hays Peer Group Review Date November 2, 1993
 Surveyor's Michigan License No. 25847 Date 11-9-93