

**SURVEY & REMONUMENTATION**


MAR 16 1998

**LAND CORNER RECORDATION CERTIFICATE**  
Filing Requirement of Act 74, Mich. P.A. 1970

**SECTION**

For corners in

|   |                           |               |
|---|---------------------------|---------------|
| <u>MASON</u><br><small>(County)</small> | Located In:               | Corner Code # |
| 1. Public Land Survey                   | T <u>17N</u> R <u>16W</u> | K-2           |
|   | T _____ R _____           |               |
|   | T _____ R _____           |               |
|   | T _____ R _____           | <i>Sec. 2</i> |
| 2. Property Controlling in Section      | S _____ T _____ R _____   |               |
|   | S _____ T _____ R _____   |               |
| 3. Miscellaneous Property in Sec.       | S _____ T _____ R _____   |               |
|   | S _____ T _____ R _____   |               |
| 4. Lot No. _____, Recorded Plat _____   |                           |               |
| 5. Private Claims _____                 |                           |               |

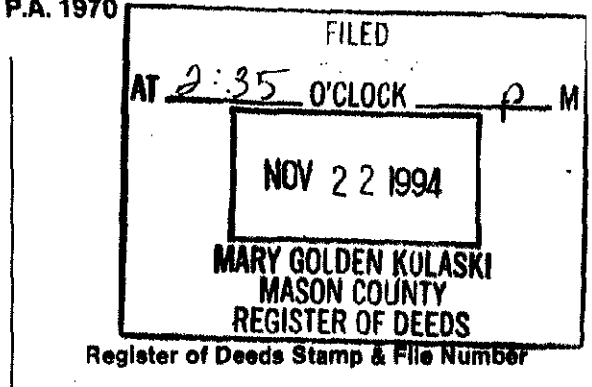

| A  | B  | C  | D  | E  | F  | G  | H | I | J | K | L | M |
|----|----|----|----|----|----|----|---|---|---|---|---|---|
| 2  | 6  | 5  | 4  | 3  | 2  | 1  |   |   |   |   |   |   |
| 3  |    |    |    |    |    |    |   |   |   |   |   |   |
| 4  | 7  | 8  | 9  | 10 | 11 | 12 |   |   |   |   |   |   |
| 5  |    |    |    |    |    |    |   |   |   |   |   |   |
| 6  | 18 | 17 | 16 | 15 | 14 | 13 |   |   |   |   |   |   |
| 7  |    |    |    |    |    |    |   |   |   |   |   |   |
| 8  | 19 | 20 | 21 | 22 | 23 | 24 |   |   |   |   |   |   |
| 9  |    |    |    |    |    |    |   |   |   |   |   |   |
| 10 | 30 | 29 | 28 | 27 | 26 | 25 |   |   |   |   |   |   |
| 11 |    |    |    |    |    |    |   |   |   |   |   |   |
| 12 | 31 | 32 | 33 | 34 | 35 | 36 |   |   |   |   |   |   |
| 13 |    |    |    |    |    |    |   |   |   |   |   |   |

I, Theodore H. Weinert, in a field survey on OCTOBER, 19 94, do hereby certify that under requirements of P.A. 74, Michigan P.A. of 1970, the corner points mentioned in lines 1 and 2 above were in conformance with regulations and rules therefore as required in the current manual of survey instructions of the United States Department of the Interior, Bureau of Land Management or by a decree of a Court of Law and/or that the corner points mentioned in lines 3, 4 and 5 above were in conformance with the rules of the Michigan Board of Land Surveyors or by a Decree of a Court of Law; established, re-established, monumented, re-monumented, recovered, found as expressed below:

**NOTE: Not more than 4 corners, all in the same town and range, may be recorded on this certificate.**

**A. Description of original monument and accessories and/or subsequent restoration:**

K-2 1/4 Corner, Secs. 1 & 2  
G.L.O. Notes Set Post  
July, 1838, John Hodgson  
8" Maple S 17 W 22 lks  
8" Maple N 30 E 5 lks  
Undated, Unsigned survey Book 1, Page 66, Mason County Records

*Survey by Stephens, R.L.S.  
MAY, 1959.  
Corner Mon. by Stephens  
North, 389.80 feet*

**B. Description of corner evidence found and/or method applied in restoring or reestablishing corner:**

K-2 1/4 Corner, Secs. 1 & 2  
No corner evidence found.  
Fence line north and south.  
Set corner on prorated distance with G.L.O. Notes  
0.5' East of north-south fence line.  
SW corner bears S 00-09-28 W 2608.81'  
NW corner bears N 00-17-39 W 2732.40'

**C. Description of monument for corner and accessories established to perpetuate locating the position of the corner:**

K-2 1/4 Corner, Secs. 1 & 2  
Set 5/8" X 36" rebar with standard 2 1/2" cap stamped "Mason County Remonumentation".  
36" DbI. Maple S 60 W 22.80'  
24" W. Oak N 11 W 57.67'  
20" R. Oak N 46 E 48.89'  
18" W. Pine S 65 E 18.91'  
12" W. Oak S 12 E 61.05'  
CL Two Track West 6.0'  
Single Strand North-South Fence East 0.5'



Signed by Theodore H. Weinert  
Surveyor's Michigan License No. 19846

Date 11-6-94

Peer Group Reviewed  
FORM APPROVED BY MICHIGAN STATE BOARD OF LAND SURVEYORS, JAN. 28, 1971  
Date: 11-5-94  
Kenneth L. Ross  
Mason County Surveyor  
Peer REVIEWED MAY 18, 1975  
REVISED APRIL 1983  
Date: Feb 23 1997