

SURVEY & REMONUMENTATION

MAR 16 1998

LAND CORNER RECORDATION CERTIFICATE
Filing Requirement of Act 74, Mich. P.A. 1970

SECTION

For corners in

MASON
(County)


Located In:

Corner Code ##

- 1. Public Land Survey T 17N R 16W
- T _____ R _____
- T _____ R _____
- T _____ R _____
- 2. Property Controlling S _____ T _____ R _____
- In Section S _____ T _____ R _____
- 3. Miscellaneous S _____ T _____ R _____
- Property in Sec. S _____ T _____ R _____

M-2

Sec. 2

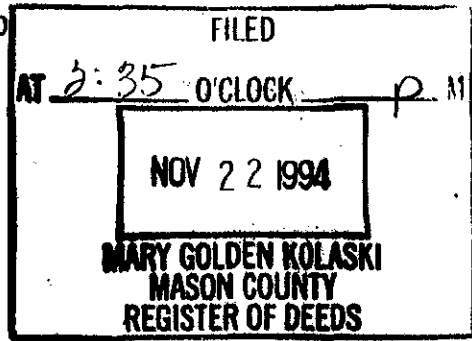

Register of Deeds Stamp & File Number

- 4. Lot No. _____, Recorded Plat _____
- 5. Private Claims _____

	A	B	C	D	E	F	G	H	I	J	K	L	M
2	6	5	4	3	2	1							
3													
4	7	8	9	10	11	12							
5													
6	13	17	16	15	14	13							
7													
8	19	20	21	22	23	24							
9													
10	30	29	28	27	26	25							
11													
12	31	32	33	34	35	36							
13													

I, Theodore H. Weinert, in a field survey on OCTOBER, 1994, do hereby certify that under requirements of P.A. 74, Michigan P.A. of 1970, the corner points mentioned in lines 1 and 2 above were in conformance with regulations and rules therefore as required in the current manual of survey instructions of the United States Department of the Interior, Bureau of Land Management or by a decree of a Court of Law and/or that the corner points mentioned in lines 3, 4 and 5 above were in conformance with the rules of the Michigan Board of Land Surveyors or by a Decree of a Court of Law; established, re-established, monumented, re-monumented, recovered, found as expressed below:

NOTE: Not more than 4 corners, all in the same town and range, may be recorded on this certificate.

A. Description of original monument and accessories and/or subsequent restoration:


M-2 1/4 Corner, Secs. 1-17-16 & 6-17-15
G.L.O. Notes Set Post
July, 1838, John Hodgson
6" Pine S 50 W 6 lks
8" Pine N 46 W 29 lks
Undated, Unsigned survey Book 1, Page 66, Mason County Records

B. Description of corner evidence found and/or method applied in restoring or reestablishing corner:

M-2 1/4 Corner, Secs. 1-17-16 & 6-17-15
No corner evidence found.
Prorated corner as per G.L.O. Notes on a straight line between the SE corner and NE corner of section 1. No occupation in this area. Undated, unsigned survey did not tie this point.
To SE corner bears S 01-26-12 W 2623.11'
To NE corner bears N 01-26-12 E 2705.74'

C. Description of monument for corner and accessories established to perpetuate locating the position of the corner:

M-2 1/4 Corner, Secs. 1-17-16 & 6-17-15
Set 5/8" X 36" rerod with standard 2 1/2" cap stamped "Mason County Remonumentation".
18" DbL. W. Oak S 12 W 17.58'
6" DbL. W. Oak N 70 W 64.03'
12" W. Oak N 56 W 56.35'
10" W. Oak N 31 W 56.78'
8" W. Oak N 06 W 33.27'
12" W. Oak N 75 E 32.08'

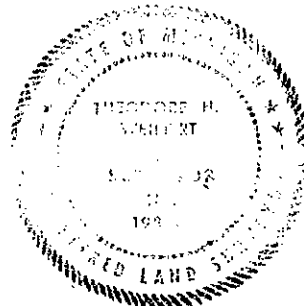

Peer Group Reviewed and Approved
Date: 11-6-94
Kenneth E. Robb
Mason County Surveyor

Signed by Theodore H. Weinert

Date 11-6-94

Surveyor's Michigan License No. 19846

Peer Group Reviewed and Approved
Date: 11-7-94