

SURVEY & REMONUMENTATION

FEB 08 2000

LAND CORNER RECORDATION CERTIFICATE

Filing Requirement of Act 74, Mich. P.A. 1970

SECTION

For corners in MASON Located In: _____ Corner Code # _____
 (County)

1. Public Land Survey T 17N R 17W E-8
 T _____ R _____
 T _____ R _____
 T _____ R _____


2. Property Controlling S _____ T _____ R _____
 in Section S _____ T _____ R _____

3. Miscellaneous S _____ T _____ R _____

Property in Sec. S _____ T _____ R _____

4. Lot No. _____, Recorded Plat _____

5. Private Claims _____

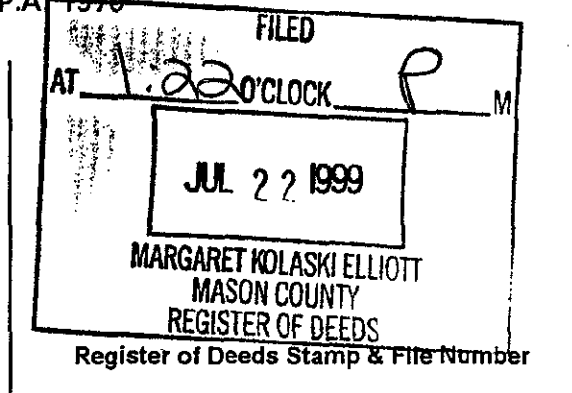

	A	B	C	D	E	F	G	H	I	J	K	L	M
1													
2	6	5	4	3	2	1							
3													
4	7	8	9	10	11	12							
5													
6	18	17	16	15	14	13							
7													
8	19	20	21	22	23	24							
9													
10	30	29	28	27	26	25							
11													
12	31	32	33	34	35	36							
13													

I, Kenneth L. Ross, in a field survey on May 15, 1999, do hereby certify that under requirements of P.A. 74, Michigan P.A. of 1970, the corner points mentioned in lines 1 and 2 above were in conformance with regulations and rules therefore as required in the current manual of survey instructions of the United States Department of the Interior, Bureau of Land Management or by a decree of a Court of Law and/or that the corner points mentioned in lines 3, 4 and 5 above were in conformance with the rules of the Michigan Board of Land Surveyors or by a Decree of a Court of Law; established, re-established, monumented, re-monumented, recovered, found as expressed below:

NOTE: Not more than 4 corners, all in the same town and range, may be recorded on this certificate.

A. Description of original monument and accessories and/or subsequent restoration:

E-8, 1/4 Corner Common to Sections 20 and 21, T.17N., R.17W.

- | | | |
|--|---|--|
| <p>GLO by John Hodgson, 4th quarter, 1838
 "Set quarter Section post"
 (1) Beech, 12", S35°E, 30 links (19.8')
 (2) Beech, 8", N53°W, 40 links (24.0')</p> <p>September, 1888, Book 1, page 202
 A. Mitchell, No comment on corner
 (3) NBT, Beech, 18", West, 22 links (14.52')
 Distance North to E-7, 2704.02'
 Distance South to E-9, 2633.40'</p> <p>April, 1892, Book 1, page 256
 W.E. Metcalf, No Comment on corner
 No witnesses given.
 Distance South to E-9, 2635.38'</p> | <p>February, 1967, Consumers Power Co.
 K.B. Stephens, File SF-16758
 "Found 1 1/4" Iron"
 (4) Road Name Sign, N54°E, 33.65'
 (5) 12" Maple, S72°W, 115.71'
 (6) P.P./Trans, S08°E, 165.36'</p> <p>March, 1968, Consumers Power Co.
 K.B. Stephens, "Fd. 1 1/4" Pipe"
 (4) Distance, 44.32'
 Witnesses (5) & (6) given
 (7) Guyed T.P., N54°E, 33.65'
 Distance North to E-7, 2688.84'
 Distance South to E-9, 2633.82'</p> | <p>April, 1975, File B-93
 K.L. Ross, "Fd 1 1/4" iron"
 Witness (3), distance 44.32'
 Witnesses (6) and (7) given
 Distance North to E-7, 2688.04'
 Distance South to E-9, 2633.82'</p> <p>December, 1976, File B-111
 K.L. Ross, "Fd. 1 1/4" iron"
 Witnesses (4), (6) and (7) given
 Distance North to E-7, 2686.88'</p> <p>June, 1978, Act 132, Liber 2, page 46
 June, 1981, Act 132, K.L. Ross,
 "Fd. 1 1/4" iron, Witnesses (4) & (6)
 given Distance North to E-7, 2686.79'</p> |
|--|---|--|

B. Description of corner evidence found and/or method applied in restoring or reestablishing corner:

E-8, 1/4 Corner Common to Sections 20 and 21, T.17N., R.17W.,


Found 1 1/4" T Post, 36" long about 8" below the surface of Morton Road, next to two stones one on top of the other with broken pieces of a plow share along side. Witnesses (1), (2), (3) & (4) have been destroyed. Witnesses (5), (6) and (7) are standing and in good condition. I found no other evidence to dispute the location of this corner.

C. Description of monument for corner and accessories established to perpetuate locating the position of the corner:

- E-8, 1/4 Corner Common to Sections 20 and 21, T.17N., R.17W.,
 I replaced the 1 1/4" T post as described above in the exact location, with a Harrison cast iron monument stamped MASON COUNTY MONUMENT, placed 1.0 feet below the road surface of Morton Road, leaving one stone in place on north side and pieces of plow share thrown in as it was backfilled. This corner is accepted as a careful and faithful re-establishment of the position of the original corner.
- (5) 15" maple, existing 60d spike, North side, S72°W, 115.70'
 - (6) P.P. with Trans. Existing 60d spike SW side, S08°E, 165.36'
 - (7) T. Guard pole and Box, existing 60d spike, South Side, N59°E, 33.69'
 - (8) Center of Tel Cable Sign Post, N38°E, 35.55'
 - (9) Center of Stop Sign Post, S65°W, 44.93'

Signed by [Signature] Date 7-21-99

Surveyor's Michigan License No. 17634

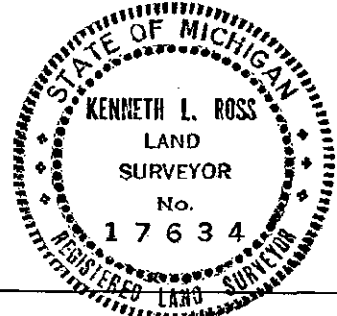

Peer Group Reviewed and Approved
 Date: 7-21-99
[Signature]
 Kenneth L. Ross