

SURVEY & REMONUMENTATION

FEB 08 2000

LAND CORNER RECORDATION CERTIFICATE

Filing Requirement of Act 74, Mich. P.A. 1970

SECTION

For corners in

MASON


(County)

Located In:

Corner Code #

- 1. Public Land Survey T 17N R 17W F-7
- T _____ R _____
- T _____ R _____
- T _____ R _____
- 2. Property Controlling S _____ T _____ R _____
- in Section S _____ T _____ R _____
- 3. Miscellaneous S _____ T _____ R _____
- Property in Sec. S _____ T _____ R _____

- 4. Lot No. _____, Recorded Plat _____
- 5. Private Claims _____

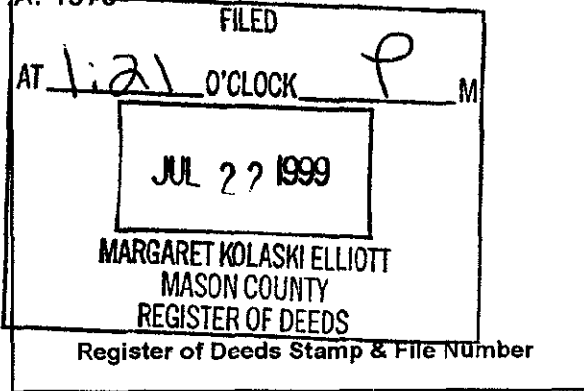

I, Kenneth L. Ross, in a field survey on May 15, 1999, do hereby certify that under requirements of P.A. 74, Michigan P.A. of 1970, the corner points mentioned in lines 1 and 2 above were in conformance with regulations and rules therefore as required in the current manual of survey instructions of the United States Department of the Interior, Bureau of Land Management or by a decree of a Court of Law and/or that the corner points mentioned in lines 3, 4 and 5 above were in conformance with the rules of the Michigan Board of Land Surveyors or by a Decree of a Court of Law; established, re-established, monumented, re-monumented, recovered, found as expressed below:

	A	B	C	D	E	F	G	H	I	J	K	L	M
1													
2	6	5	4	3	2	1							
3													
4	7	8	9	10	11	12							
5													
6	18	17	16	15	14	13							
7													
8	19	20	21	22	23	24							
9													
10	30	29	28	27	26	25							
11													
12	31	32	33	34	35	36							
13													

NOTE: Not more than 4 corners, all in the same town and range, may be recorded on this certificate.

A. Description of original monument and accessories and/or subsequent restoration:

- F-7, 1/4 Corner Common to Sections 16 and 21, T.17N., R.17W.,
GLO by John Hodgson, April, 1892, Book 1, page 225
4th quarter, 1838 W.E. Metcalf, no comment on corner
Set quarter section post No Witnesses Given
(1) Beech, 12", S39°E, 21 lks(13.86') Distance West to E-7, 2671.68'
(2) Beech, 10", S17°W, 12 lks(7.92') Distance East to G-7, 2671.68'
- September 7, 1965, File B-63
K. B. Stephens, "Set 1/2" pipe
No Witnesses Given,
Distance East to G-7, 2670.94'
- Date unknown, Book 1, page 34 & 35 December, 1905, Book 2, page 121, May, 1968, Consumers Power Survey
Surveyor unknown, "planted stone" R.O. Towns, "Stone at Corner" K.B. Stephens, File S-F 17051
No witness were found or taken No Witnesses Given "Found 1/2" pipe
Distance West to E-7, 2657.16' Distance East to G-7, 2671.68'
Distance East to G-7, 2657.16' (3) P.P. N 60°W, 101.07'
(4) T.P. N 60°E, 61.40'
(5) P.P. S 62°E, 69.51'

B. Description of corner evidence found and/or method applied in restoring or reestablishing corner:


F-7, 1/4 Corner Common to Sections 16 and 21, T.17N., R.17W.,
Found 1/2" pipe on the center-line of Meisenhimer Road rusted out and broken. Witnesses (1), (2), (4), and (5) have been destroyed. Found witness (3) P.P. N 56° W, 101.10' There are other witness trees in the area, but I was unable to obtain the data for these witnesses. I found no other evidence to dispute the location of this corner.

C. Description of monument for corner and accessories established to perpetuate locating the position of the corner:

F-7, 1/4 Corner Common to Sections 16 and 21, T.17N., R.17W.,
I replaced the 1/2" pipe as described above in the exact location, with a Harrison cast iron monument stamped MASON COUNTY MONUMENT, placed 1.0 feet below the road surface. This corner is accepted as the best available evidence of the position of the original corner.
(3) P.P. N 56°W, existing 60d spike, NE side, 101.10 feet
(6) New Bearing Post, existing 60d Spike SE side of Treated 3"X 4" Post, N 30°E, 46.80 feet
(7) New Bearing Post, existing 60d spike NE side of P.P., S 16°E, 30.20 feet
(8) New Bearing Tree, set 60d spike NE side of a clump of six, 3" to 8" Basswoods N 15° W, 44.75'
Note: Witnesses (6) and (7) are existing witnesses but I was unable to obtain any data on the origination of these witnesses.

Signed by [Signature]
Surveyor's Michigan License No. 17634

Date 7-21-99

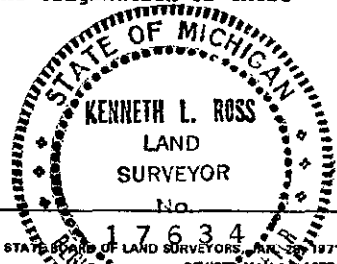

Peer Group Reviewed and Approved
Date: 7-14-99
[Signature]
Kenneth L. Ross

FORM APPROVED BY MICHIGAN STATE BOARD OF LAND SURVEYORS, APRIL 28, 1971
REVISED MAY 1975
ADAPTED FOR LAND PROCESSING, MARCH, 1993