

SURVEY & REMONUMENTATION

FEB 08 2000

LAND CORNER RECORDATION CERTIFICATE

Filing Requirement of Act 74, Mich. P.A. 1970

SECTION

For corners in


MASON
(County)

Located In:

Corner Code #

- 1. Public Land Survey T 17N R 17W F-9
- T _____ R _____
- T _____ R _____
- T _____ R _____
- 2. Property Controlling S _____ T _____ R _____
- in Section S _____ T _____ R _____
- 3. Miscellaneous S _____ T _____ R _____
- Property in Sec. S _____ T _____ R _____

- 4. Lot No. _____, Recorded Plat _____
- 5. Private Claims _____

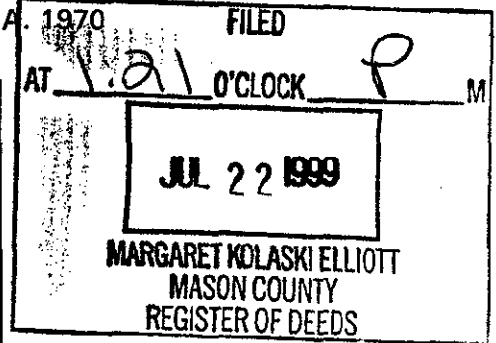

Register of Deeds Stamp & File Number

I, Kenneth L. Ross, in a field survey on May 15, 1999, do hereby certify that under requirements of P.A. 74, Michigan P.A. of 1970, the corner points mentioned in lines 1 and 2 above were in conformance with regulations and rules therefore as required in the current manual of survey instructions of the United States Department of the Interior, Bureau of Land Management or by a decree of a Court of Law and/or that the corner points mentioned in lines 3, 4 and 5 above were in conformance with the rules of the Michigan Board of Land Surveyors or by a Decree of a Court of Law, established, re-established, monumented, re-monumented, recovered, found as expressed below:

NOTE: Not more than 4 corners, all in the same town and range, may be recorded on this certificate.

A. Description of original monument and accessories and/or subsequent restoration:

- F-9, ¼ Corner Common to Sections 21 and 28, T.17N., R.17W.,
- GLO by John Hodgson, April 1898, book 1, page 76
- 4th quarter, 1838 R.O. Towns, "Stone"
- Set quarter section post No Witnesses Given
- (1) Beech, 18", S12°W, 40 links (26.4') Distance East to G-9, 2676.96'
- (2) Beech, 24", N12°E, 18 links (10.8') Distance West to E-9, 2641.32'
- April, 1892, Book 1, Page 256 1964, R.E. Lunde, MCRC
- W.E. Metcalf, No Comment on Corner Steel Axle and Large Stone
- Distance East to G-9, 2689.50' (3) P.P. NW, 96.2'
- Distance West to E-9, 2653.20' (4) P.P. SW, 43.1'

- May, 1968, Consumers Power Co.
- K.B. Stephens, "Set R.R. Spike"
- (3) P.P. NW, 96.87'
- (4) Trans Pole, SW, 43.85'
- (5) Guy and Tel Pole NE, 44.80'
- Distance East to G-9, 2649.82'
- Distance West to E-9, 2649.82'

B. Description of corner evidence found and/or method applied in restoring or reestablishing corner:


F-9, ¼ Corner Common to Sections 21 and 28, T.17N., R.17W.,
 Found 1" iron pipe X 18" Long, 3 foot South of the Center-line of Anthony Road on Orchard Line North and South. Witnesses (1) and (2) have been destroyed. Witnesses (3), (4) and (5) are standing and in good condition. I found no other evidence to dispute the location of this corner.

C. Description of monument for corner and accessories established to perpetuate locating the position of the corner:

- F-9, ¼ Corner Common to Sections 21 and 28, T.17N., R.17W.,
- I replaced the 1"X 18" pipe, as described above in the exact location, with a Harrison cast iron monument stamped MASON COUNTY MONUMENT, placed 3" below the road surface and placed a Monument Box. This corner is accepted as a careful and faithful re-establishment of the position of the original corner.
- (3) P.P., P.K. Nail South Side, N58°W, 96.35'
- (4) Trans Pole, Set 60d spike, SE side, S28°W, 43.34'
- (5) Tel Guard Pole & Box, Set 60d Spike, NW Side, N51°E, 44.68'
- (6) NBT Center of 3" Apple, S10°W, 68.75'
- (7) NBT, Center of 2" Apple, N20°W, 59.00'

Signed by [Signature]
 Surveyor's Michigan License No. 17634

Date 7-21-99

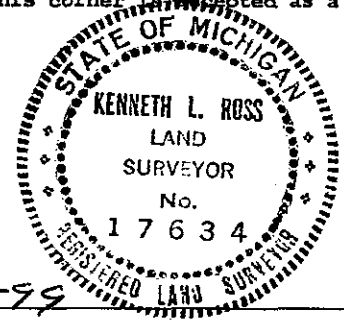

Peer Group Reviewed and Approved
 Date: 7-14-99
[Signature]
 Kenneth L. Ross