

SURVEY & REMONUMENTATION

FEB 08 2000

SECTION

LAND CORNER RECORDATION CERTIFICATE

Filing Requirement of Act 74, Mich. P.A. 1970

For corners in MASON Located In: _____ Corner Code # _____
 (County)

1. Public Land Survey T 17N R 17W _____ G-7
 T _____ R _____
 T _____ R _____
 T _____ R _____


2. Property Controlling S _____ T _____ R _____
 in Section S _____ T _____ R _____

3. Miscellaneous S _____ T _____ R _____

Property in Sec. S _____ T _____ R _____

4. Lot No. _____, Recorded Plat _____

5. Private Claims _____

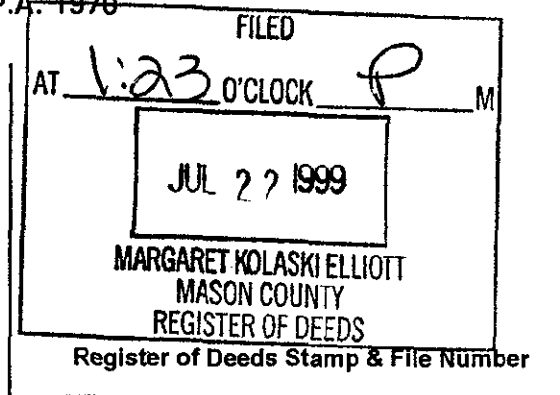

	A	B	C	D	E	F	G	H	I	J	K	L
1												
2	6	5	4	3	2	1						
3												
4	7	8	9	10	11	12						
5												
6	18	17	16	15	14	13						
7												
8	19	20	21	22	23	24						
9												
10	30	29	28	27	26	25						
11												
12	31	32	33	34	35	36						
13												

I, Kenneth L. Ross, in a field survey on May 15, 1999, do hereby certify that under requirements of P.A. 74, Michigan P.A. of 1970, the corner points mentioned in lines 1 and 2 above were in conformance with regulations and rules therefore as required in the current manual of survey instructions of the United States Department of the Interior, Bureau of Land Management or by a decree of a Court of Law and/or that the corner points mentioned in lines 3, 4 and 5 above were in conformance with the rules of the Michigan Board of Land Surveyors or by a Decree of a Court of Law; established, re-established, monumented, re-monumented, recovered, found as expressed below:

NOTE: Not more than 4 corners, all in the same town and range, may be recorded on this certificate.


- A. Description of original monument and accessories and/or subsequent restoration:**
- G-7, Corner Common to Sections 15, 16, 21 and 22, T.17N., R.17W., GLO by John Hodgson 4th quarter, 1838. March, 1901, Book 2, page 111 & 112 R.O. Towns, "Found Tile" No Witnesses Given
 Set Post Cor. Sections 15,16,21 & 22'
 (1) Lynn, 10", S 26°E, 55 links(36.3') Distance East to H-7, 2642.64'
 (2) Beech, 12", N 72°W, 34 links(22.44') Distance South to G-8, 2626.80'
 - Undated, Book 1, Page 34 and 35 Surveyor unknown "established by Intersection, planted stone" May, 1904, Book 2, Page 114 & 115 and Book 4, page 132. R.O. Towns "Stone/w/x" No Witnesses Given
 Distance West to F-7, 2657.16 feet Distance North to G-6, 2541.00 feet
 Distance North to G-6, 2531.76'
 Distance East to H-7, 2646.60'
 - March 1880, Book 1, page 87 John A. Mitchell "found stone" December, 1905, Book 2, page 121 R.O. Towns, "Stone/w/x" No Witnesses Given
 Witness Trees Standing
 Distance East to H-7, 2628.78 feet Distance West to F-7, 2671.68'
 Distance North to G-6, 2641.00 feet Distance North to G-6, Not Given
 - April, 1882, Book 1, page 256 W.E. Metcalf, No Comment on Cor Sept. 7, 1965, File B-63
 Distance West, to F-7, 2671.68 K.B. Stephens, "Fd. 3/4" pipe" No Witnesses Given
 Distance South to G-8, 2631.42' Distance West to F-7, 2670.94'

- May, 1968, Consumers Power Co. K.B. Stephens, File S-F 17051 "Fd 3/4" pipe"
 (3) Guard Rail Post, N85°E, 81.26'
 (4) P.P. #465, S33°E, 58.05'
 (5) T.P. N65°W, 63.42'
 (6) Stop Sign, S77°W, 60.9'
- July, 1973, Gile B-89, LCRC, Liber 1, page 96, K.L. Ross, "Set P.K. over iron"
 (7) Road Name Sign, SE, 45.15' Witness (4), distance 58.10'
 Witness (6), distance 60.67'
 (8) Buried Cable Sign, NW 49.20' Distance North to G-6, 2641.04'
 Distance East to H-7, 2655.25'
- February, 1992, File 92047S K.L. Ross, "Fd. 3/4" pipe" No Witnesses Given
 Distance South to G-8, 2622.61'
 Distance East to H-7, 2655.35'

B. Description of corner evidence found and/or method applied in restoring or reestablishing corner:
 G-7, Corner Common to Sections 15, 16, 21 and 22, T.17N., R.17W., Found 3/4" X 30" Galvanized Iron Pipe in Center-line of Stiles Road and Center-line of Meisenhimer Road, Witnesses (1), (2), (3), (5), (6) and (7) have been destroyed. Witnesses (4) and (8) are standing and in good condition. I found no other evidence to dispute the location of this corner.

- C. Description of monument for corner and accessories established to perpetuate locating the position of the corner:**
 G-7, Corner Common to Sections 15, 16, 21 and 22, T.17N., R.17W., I replaced the 3/4" pipe as described above in the exact location, with a Harrison cast iron monument stamped MASON COUNTY MONUMENT, placed 3" below the road surface and placed a Monument Box. This corner is accepted as the best available evidence of the position of the original corner.
- (4) P.P. 60d spike SW side, S30°E, 58.03'
 - (8) Center of Burid Cable Sign Post, N52°W, 49.20'
 - (9) New Bearing Post, Center of Stop Sign Post, S72°W, 45.55'
 - (10) New Bearing Post, 60d spike top of Guard Rail Post, N38°W, 39.14'
 - (11) New Bearing Post, 60d spike top of Guard Rail Post, N45°E, 43.45'
 - (12) New Bearing Post, 60d spike top of Guard Rail Post, S48°E, 40.62'
 - (13) New Bearing Post, 60d spike top of Guard Rail Post, S38°W, 38.75'

Signed by [Signature] Date 7-21-99
 Surveyor's Michigan License No. 17634

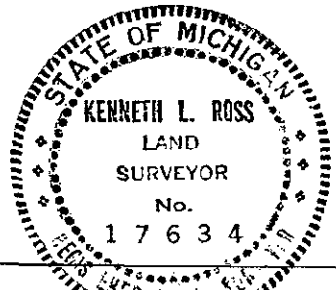

Peer Group Reviewed and Approved
 Date: 7-14-99
[Signature]
 Kenneth L. Ross