

SURVEY & REMONUMENTATION

FEB 08 2000


LAND CORNER RECORDATION CERTIFICATE

Filing Requirement of Act 74, Mich. P.A. 1970

For corners in **SECTION**
MASON
 (County)

Located In:

Corner Code #

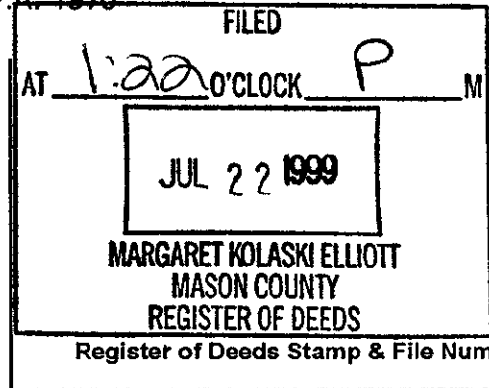

- 1. Public Land Survey T 17N R 17W G-8
- 2. Property Controlling in Section S T R
- 3. Miscellaneous S T R
- Property in Sec. S T R
- 4. Lot No. _____, Recorded Plat _____
- 5. Private Claims _____

	A	B	C	D	E	F	G	H	I	J	K	L	M
1													
2	6	5	4	3	2	1							
3													
4	7	8	9	10	11	12							
5													
6	18	17	16	15	14	13							
7													
8	19	20	21	22	23	24							
9													
10	30	29	28	27	26	25							
11													
12	31	32	33	34	35	36							
13													

I, Kenneth L. Ross, in a field survey on May 15, 1999, do hereby certify that under requirements of P.A. 74, Michigan P.A. of 1970, the corner points mentioned in lines 1 and 2 above were in conformance with regulations and rules therefore as required in the current manual of survey instructions of the United States Department of the Interior, Bureau of Land Management or by a decree of a Court of Law and/or that the corner points mentioned in lines 3, 4 and 5 above were in conformance with the rules of the Michigan Board of Land Surveyors or by a Decree of a Court of Law; established, re-established, monumented, re-monumented, recovered, found as expressed below:

NOTE: Not more than 4 corners, all in the same town and range, may be recorded on this certificate.

A. Description of original monument and accessories and/or subsequent restoration:
 G-8, 1/4 Corner Common to Sections 21 and 22, T.17N., R.17W.,
 GLO by John Hodgson, March, 1901, Book 2, page 111 & 112
 4th quarter, 1838 R.O. Towns, "Stone"
 Set quarter section post No Witnesses Given
 (1) Hemlock, 12", N32°E, 8 links (5.28') Distance North to G-7, 2626.80'
 (3) Hemlock, 10", S63°W, 14 links (8.40') Distance South to G-9, 2634.72'

February, 1992, Act 132
 K.L. Ross, "Found 1/2" iron rebar"
 No Witnesses Given
 Distance North to G-7, 2622.61'
 Distance South to G-9, 2624.13'


April, 1892, Book 1, page 256 May, 1968, Consumers Power Co.
 W.E. Metcalf, No comment on corner K.B. Stephens, "Set 1/2" iron, 1/2 way on line
 Distance North to G-7, 2631.42' (3) S.E. Cor. Barn SW, 105.38'
 Distance South to G-9, 2634.72' (4) P.P. NW, 59.78'
 (5) Fence to East
 Distance North to G-7, 2623.79'
 Distance South to G-9, 2623.79'

B. Description of corner evidence found and/or method applied in restoring or reestablishing corner:
 G-8, 1/4 Corner Common to Sections 21 and 22, T.17N., R.17W.,

Found 1/2" X 12" Rebar and described by K.B. Stephens, and K.L. Ross. Large Stone on East Side of rebar location, 1.5 foot below bituminous surface (left in place). Witnesses (1) and (2) have been destroyed. Witnesses (3), (4) and (5) are standing and in good condition.
 I found no other evidence to dispute the location of this corner.

C. Description of monument for corner and accessories established to perpetuate locating the position of the corner:
 G-8, 1/4 Corner Common to Sections 21 and 22, T.17N., R.17W.,
 I replaced the 1/2" X 12" rebar, as described above in the exact location, with a Harrison cast iron monument stamped MASON COUNTY MONUMENT, placed 3" below the road surface and placed a Monument Box. This corner is accepted as a careful and faithful re-establishment of the position of the original corner.

- (3) SE corner of barn, S75°W, 105.40'
- (4) P.P. N 75°W, existing 60d spike North side, 59.75'
- (5) Fence to East
- (6) NBP, North Gate Post, set 60d spike, SW side, S26°W, 73.32'
- (7) NBT, Elm, 6", set 60d spike SW side, S41°E, 46.91'
- (8) NBT, 4" Elm, set 60d spike, SE side, N49°E, 44.55'

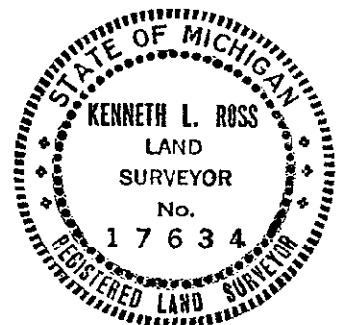

Signed by [Signature]
 Surveyor's Michigan License No. 17634

Date 7-21-99

Peer Group Reviewed and Approved
 Date: 7-12-99
[Signature]
 Kenneth L. Ross

LIBER

4 PAGE 261