

SURVEY & REMONUMENTATION

FEB 08 2000

LAND CORNER RECORDATION CERTIFICATE

Filing Requirement of Act 74, Mich. P.A. 1970


SECTION

For corners in MASON
(County)

Located In:

Corner Code #

- 1. Public Land Survey T 17N R 17W G-9
- 2. Property Controlling in Section S T R
- 3. Miscellaneous S T R
- Property in Sec. S T R
- 4. Lot No. , Recorded Plat
- 5. Private Claims

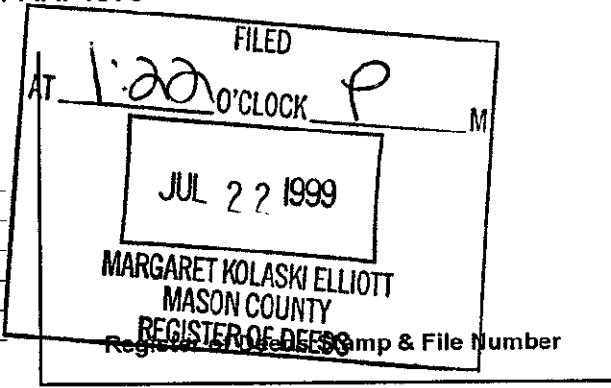

I, Kenneth L. Ross, in a field survey on May 15, 1999, do hereby certify that under requirements of P.A. 74, Michigan P.A. of 1970, the corner points mentioned in lines 1 and 2 above were in conformance with regulations and rules therefore as required in the current manual of survey instructions of the United States Department of the Interior, Bureau of Land Management or by a decree of a Court of Law and/or that the corner points mentioned in lines 3, 4 and 5 above were in conformance with the rules of the Michigan Board of Land Surveyors or by a Decree of a Court of Law; established, re-established, monumented, re-monumented, recovered, found as expressed below:

NOTE: Not more than 4 corners, all in the same town and range, may be recorded on this certificate.

A. Description of original monument and accessories and/or subsequent restoration:

G-9, ¼ Corner Common to Sections 21, 22, 27 and 28, T.17N., R.17W., GLO by John Hodgson, March, 1901, Book 2, Page 111 & 112 and Book 4, page 30, R.O. Towns, 4th quarter, 1838 "Stone" No witnesses Set post common to secs. 21, 22, 27 & 28 (1) Beech, 30", N22°W, 45 links (28.38') Distance East to H-9, 2661.12' (2) Beech, 18", S75°E, 21 links (12.6') Distance North to G-8, 2634.72'

April, 1892, Book 1, page 256 W.E. Metcalf, No comment on corner Distance West to F-9, 2689.50' Distance North to G-8, 2634.72'

April, 1898, Book, 1, page 76, R.O. Towns, "Stone" No witnesses Distance West to F-9, 2676.96' Distance South to G-10, 2692.80'

May, 1968, Consumers Power Co. K.B. Stephens, "Set RR Spike" (3) Guy Pole, S80°E, 36.53' (4) P.P. S75°W, 39.15' (5) Guy Pole, N76°W, 44.23' (6) Stop Sign, N30°E, 54.75' Distance North to G-8, 2623.79' Distance West to F-9, 2688.36'

August, 1976, Act 132 James T. Nordlund, No Comment on Cor Distance South to G-10, North Given Distance East to H-9, Not Given

February, 1992, Act 132 K.L. Ross, "Pd. RR Spike" No Witnesses Given Distance North to G-8, 2624.13'

May, 1993, Act 132 K.L. Ross, "existing RR Spike" No Witnesses Given Distance South to G-10, 2664.63'

B. Description of corner evidence found and/or method applied in restoring or reestablishing corner:

G-9, ¼ Corner Common to Sections 21, 22, 27 and 28, T.17N., R.17W.,


Found R.R. Spike, 3' East of Center-line of Stiles Road and on the projected center-line of Anthony Road. Witnesses (1), (2) and (6) have been destroyed. Witnesses (3), (4) and (5) are standing and in good condition. I found no other evidence to dispute the location of this corner.

C. Description of monument for corner and accessories established to perpetuate locating the position of the corner:

G-9, ¼ Corner Common to Sections 21, 22, 27 and 28, T.17N., R.17W.,

I replaced the R.R. Spike, as described above in the exact location, with a Harrison cast iron monument stamped MASON COUNTY MONUMENT, placed 3" below the road surface and placed a Monument Box. This corner is accepted as a careful and faithful re-establishment of the position of the original corner.

- (3) Guy Pole, existing 60d spike, NE side, S42°E, 36.52'
- (4) P.P., existing 60d spike, SW side, S54°W, 39.21'
- (5) Guy Pole, existing 60d spike, SW side, N40°W, 44.15'
- (6) Center of Stop Sign Post, N79°E, 53.02'
- (7) Center of Stop Sign Post, S62°W, 39.68'

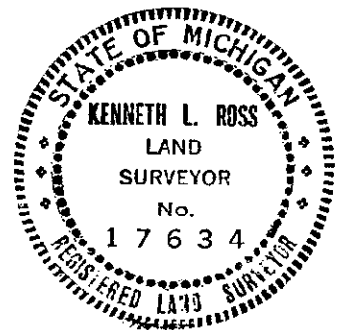

Signed by [Signature] Date 7-21-99

Surveyor's Michigan License No. 17634

Peer Group Reviewed and Approved Date: 7-14-99 Kenneth L. Ross Mason County Surveyor

FORM APPROVED BY MICHIGAN STATE BOARD OF LAND SURVEYORS, JAN. 28, 1971 REVISED MAY 14, 1971 REVISED JAN., 1982

LIBER

ADAPTED FOR WORD PROCESSING MARCH, 1982 4 PAGE 260