

SURVEY & REMONUMENTATION


JAN 23 2001

SECTION LAND CORNER RECORDATION CERTIFICATE

Filing Requirement of Act 74, Mich. P.A. 1970

For corners In: Located In: Corner Code #
Mason County

- | | | | |
|------------------------------------|---------------------------|-------|-------|
| 1. Public Land Survey | T <u>17N</u> R <u>17W</u> | H-11 | |
| | T _____ R _____ | _____ | _____ |
| | T _____ R _____ | _____ | _____ |
| | T _____ R _____ | _____ | _____ |
| 2. Property Controlling in Section | S _____ T _____ R _____ | _____ | _____ |
| | S _____ T _____ R _____ | _____ | _____ |
| 3. Miscellaneous Property in Sec. | S _____ T _____ R _____ | _____ | _____ |
| | S _____ T _____ R _____ | _____ | _____ |

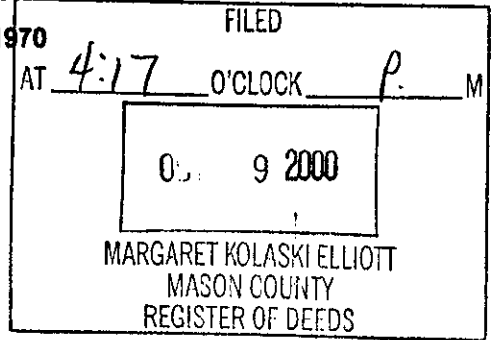

Register of Deeds Stamp & File Number

4. Lot No. _____, Recorded Plat _____
5. Private Claims _____

	A	B	C	D	E	F	G	H	I	J	K	L	M
1													
2	6	5	4	3	2	1							
3													
4	7	8	9	10	11	12							
5													
6	18	17	16	15	14	13							
7													
8	19	20	21	22	23	24							
9													
10	30	29	28	27	26	25							
11				X									
12	31	32	33	34	35	36							
13													

I, Kenneth L. Ross in a field survey on September 18, 2000, Do hereby certify that under requirements of P.A.74, Michigan P.A. of 1970, the corner points mentioned in lines 1 and 2 above were in conformance with regulations and rules therefore as required in the current manual of survey instructions of the United States Department of the Interior, Bureau of Land Management or by a decree of a Court of Law and/or that the corner points mentioned in lines 3, 4 and 5 above were in conformance with the rules of the Michigan Board of Land Surveyors or by a Decree of a Court of Law; established, re-established, monumented, re-monumented, recovered, found as expressed below:

¼ corner common to sections 22 and 27 of T17N, R17W

A. Description of original monument and accessories and/or subsequent restoration:


GLO Hodgson 1838 set qr. sec. post Hemlock 18" S47W 18 lks. (11.88') #1 Hemlock 8" N18E 22 lks. 11.88' #2 John Mitchell September, 1890, B1, P231 "stake" No witnesses or dimensions given. Bonney L265 P298, 1980 Monument box. No witnesses given.	Mason County Road Commission J. Borsfay 1971 "Old road map shows 2679.1 from NW cor. of Sec. 34. Marked with stone. With grader located the stone 2669.43' on the fence line for South." 1. post SW 26.60' #3 1. post SE 56.85' #4
--	---

B. Description of corner evidence found and/or method applied in restoring or reestablishing corner:

I found a ¾" iron pipe in a monument box 1' south of the centerline of an East-West road.
 Condition of the accessories is as follows: 1 through 4 are gone.
 I found nothing to dispute the location of this corner.

C. Description of monument for corner and accessories established to perpetuate locating the position of the corner:

I accepted the existing ¾" pipe in the monument box as a careful and faithful reestablishment of the position of the original corner. I left the corner as I found it and added no additional monumentation.
 PP S88W 313.65' (set mag. nail on N. side) #5
 PP S31E 33.55' (set mag. nail on E. side) #6
 Center of mail box post N83E 95.59' (no nail set) #7
 Center of 2" dia. maple S65E 150.28' (no nail set) #8

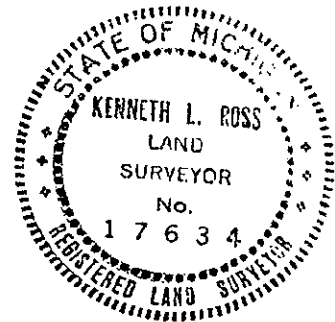

Signed by *Kenneth L. Ross* Date 10-09-2000
 Surveyor's Michigan License No. 17634

Approved by Peer Review Group on 10-25-2000
 Kenneth L. Ross, County Representative *[Signature]*

FORM APPROVED BY MICHIGAN STATE BOARD OF LAND SURVEYORS, JAN. 25,
 1971
 REVISED MAY 14, 1978
 REVISED JAN., 1983
 ADAPTED FOR WORD PROCESSING MARCH, 1983