

LAND CORNER RECORDATION CERTIFICATE
Filing Requirement of Act 74, Mich. P.A. 1970


For corners in

MASON Located In: _____ Corner Code 11
(County)

1. Public Land Survey T 17N R 17W I-3
 T _____ R _____
 T _____ R _____
 T _____ R _____

2. Property Controlling S _____ T _____ R _____
 in Section S _____ T _____ R _____

3. Miscellaneous S _____ T _____ R _____
 Property in Sec. S _____ T _____ R _____

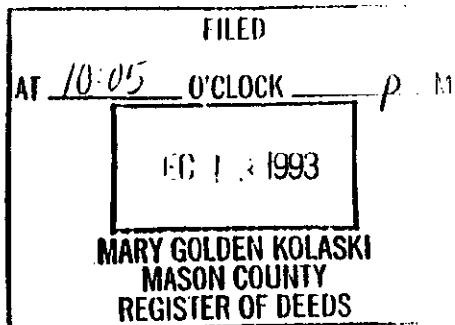

Register of Deeds Stamp & File Number

4. Lot No. _____, Recorded Plat _____
 5. Private Claims _____

	A	B	C	D	E	F	G	H	I	J	K	L	M
2	6		5		4		3		2				
3									●				
4	7		8		9		10		11				12
5													
6	16		17		16		15		14				13
7													
8	19		20		21		22		23				24
9													
10	30		29		28		27		26				25
11													
12	31		32		33		34		35				36
13													

I, John Schulke in a field survey on Sept. 16th, 1993, do hereby certify that under requirements of P.A. 74, Michigan P.A. of 1970, the corner points mentioned in lines 1 and 2 above were in conformance with regulations and rules therefore as required in the current manual of survey instructions of the United States Department of the Interior, Bureau of Land Management or by a decree of a Court of Law and/or that the corner points mentioned in lines 3, 4 and 5 above were in conformance with the rules of the Michigan Board of Land Surveyors or by a Decree of a Court of Law; established, re-established, monumented, re-monumented, recovered, found as expressed below:

NOTE: Not more than 4 corners, all in the same town and range, may be recorded on this certificate.

A. Description of original monument and accessories and/or subsequent restoration.

Original survey established in 1838 by Hogenson. Set a wooden post with the following references:
 Bearing trees: Beech 18" S62°E 25 links
 Beech 8" N55°W 48 links
 Stream 10 lks. 20.5 chains South.
 Stream 10 lks. 14.5 chains East.

In 1888, Metcalf indicated stone at corner. Northwest corner of church bears S36°45'E a distance of 161½ links. North Sixteenth corner of Sections 10 and 11 a stream 19.20 chains South (see Mason Co. Surveyor Book 1, page 204 in the Mason Co. Register of Deed's Office).

In 1877, J.A. Mitchell found witness trees standing and planted a stake (see Mason Co. Surveyor Book 1, page 46 and 47 in the Mason Co. Register of Deed's Office).

B. Description of corner evidence found and/or method applied in restoring or reestablishing corner:


Found 1/2" rebar at center line of Schwass and Kinney Roads. Found 1" iron pipe at the Quarter corner between Sections 2 and 3 bears N0°40'W a distance of 2631.48 feet. Old fence line at the Sixteenth bears North 1317.7 feet. Center of bridge bears South 1289 feet. The North Quarter corner of Section 11 bears S89°25'38"E a distance of 2641.83 feet. An old fence line running North bears East 1322 feet. Stream flowing North bears East 976 feet. The church and foundation are gone. Accepted 1/2" rebar as the best available evidence of the perpetuated location of the original corner.

C. Description of monument for corner and accessories established to perpetuate locating the position of the corner:

Replaced 1/2" rebar with 5/8" dia. X 24" iron rebar with an aluminum County cap stamped to identify the corner. The following corner references:

Power pole #22	S45°E	49.12 ft.
SE corner of house	N39°W	99.32 ft.
Road sign	S52°W	39.75 ft.
Sug. Maple	12" N16°W	93.4 ft.

Note: Rebar 1 foot below the surface of the road.

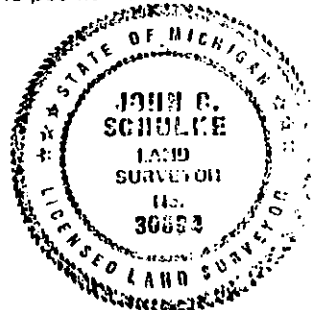

Handwritten signature and date: Date: 12-9-93

Signed by John C. Schulke
 Surveyor's Michigan License No. RLS-30894

Date Dec 12, 1993