

**SURVEY &
REMONUMENTATION**

JAN 23 2001

SECTION


LAND CORNER RECORDATION CERTIFICATE

Filing Requirement of Act 74, Mich. P.A. 1970

For corners In: Located In: Corner Code #
Mason County

- 1. Public Land Survey T 17N R 17W I-7
- 2. Property Controlling in Section S T R
- 3. Miscellaneous Property in Sec. S T R

- 4. Lot No. _____, Recorded Plat _____
- 5. Private Claims _____

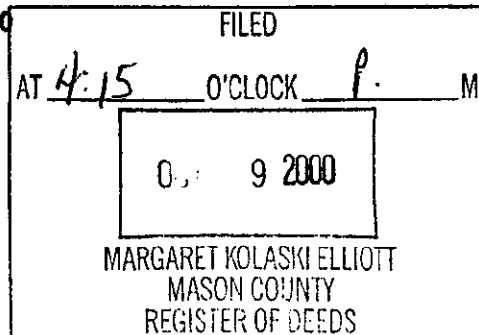

Register of Deeds Stamp & File Number

I, Kenneth L. Ross in a field survey on September 18, 2000, Do hereby certify that under requirements of P.A. 74, Michigan P.A. of 1970, the corner points mentioned in lines 1 and 2 above were in conformance with regulations and rules therefore as required in the current manual of survey instructions of the United States Department of the Interior, Bureau of Land Management or by a decree of a Court of Law and/or that the corner points mentioned in lines 3, 4 and 5 above were in conformance with the rules of the Michigan Board of Land Surveyors or by a Decree of a Court of Law; established, re-established, monumented, re-monumented, recovered, found as expressed below:

	A	B	C	D	E	F	G	H	I	J	K	L	M
1													
2	6	5	4	3	2	1							
3													
4	7	8	9	10	11	12							
5													
6	18	17	16	15	14	13							
7								*					
8	19	20	21	22	23	24							
9													
10	30	29	28	27	26	25							
11													
12	31	32	33	34	35	36							
13													

Section corner common to sections 14, 15, 22 and 23 of T17N, R17W

A. Description of original monument and accessories and/or subsequent restoration:

- GLO 1838 Hodgson "set post" 8" Beech N6W 11 lks (7.26') #1 7" Beech S76W 22 lks. (14.52') #2
- Towns 1911, B2 P 30 "located this corner by stone"
- Ross RLS 17634 Unrecorded surveys 1973, 1987, & 1990 Ex. 1" iron Dist. south to I-8 2650.82' PP N47W 47.90' #4 Rd. name sign S50W 45.93' #3 Buries cable sign S20E 56.55' #7
- John A. Mitchell March 1880 B1, P86 & 87 Stake & stone, witness trees standing
- Stephens RLS 7318, 1968 Set iron at rd. intersection Rd. name sign S51W 45.91' #3 Power pole N48E 47.85' #4 Tel. pole N32E 44.95" 5
- Schulke RLS 30894 Unrecorded & undated PP S59W 47.72' #8 PP N44W 49.25' #9 PP N54E 56.68' #10 Set iron N44-35W 47.18' #11
- Griswold 1888 B1, P201 "Post"
- Ross 17634 LCRC L1, P196 July, 1973 & unrecorded survey 1973 Found 3/4" iron PP NW 47.82' #4 Rd. name sign SW 45.88' #3 Stop sign SE 52.0' #6 Dist. north to I-6 2604.93' Dist. west to H-7 2655.32'
- Hays RLS 25847 Unrec. survey 1995 No references or witnesses

B. Description of corner evidence found and/or method applied in restoring or reestablishing corner:


I found a 1" x 12" solid iron 6" below the gravel surface.
The condition of the accessories is as follows: 1 through 7 are gone. 8, 9, 10, and 11 are in good condition.
I found nothing to dispute the location of this corner.

C. Description of monument for corner and accessories established to perpetuate locating the position of the corner:

I replaced the existing 1" x 12" solid iron with a Harrison Monument stamped "Mason County Monument RLS 17634". I accepted this as a careful and faithful reestablishment of the position of the original corner.

- PP S56W 47.73' (ex. 50d nail on SE side) #8
- PP N47W 49.35' (ex. 50d nail on NW side) #9
- PP N58E 56.50' (ex. 50d nail on NW side) #10
- 1/2" capped iron (Schulke 30894) N42W 47.34' #11

Signed by [Signature] Date 10-09-2000
Surveyor's Michigan License No. 17634

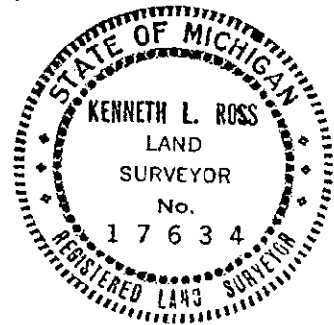

Approved by Peer Review Group on 10-05-2000
Kenneth L. Ross, County Representative [Signature]

FORM APPROVED BY MICHIGAN STATE BOARD OF LAND SURVEYORS, JAN. 28, 1971
REVISED MAY 14, 1978
REVISED JAN., 1983
ADAPTED FOR WORD PROCESSING MARCH, 1983