

**SURVEY &
REMONUMENTATION**

JAN 23 2001


SECTION

LAND CORNER RECORDATION CERTIFICATE

Filing Requirement of Act 74, Mich. P.A. 1970

For corners In: Located In: Corner Code #
Mason County

- 1. Public Land Survey T 17N R 17W I-8
T R
T R
T R
- 2. Property Controlling in Section S T R
S T R
- 3. Miscellaneous S T R
- Property in Sec. S T R

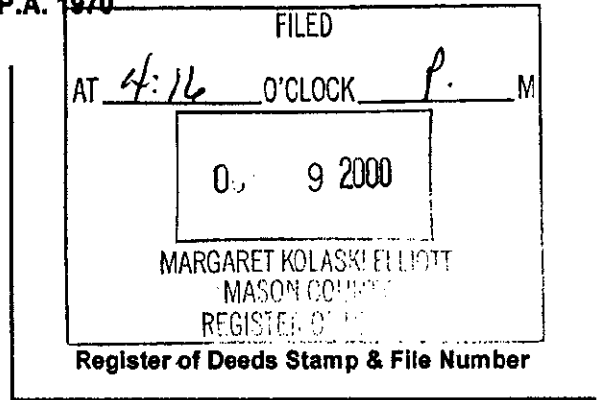

- 4. Lot No. _____, Recorded Plat _____
- 5. Private Claims _____

	A	B	C	D	E	F	G	H	I	J	K	L	M
1													
2	6	5	4	3	2	1							
3													
4	7	8	9	10	11	12							
5													
6	18	17	16	15	14	13							
7													
8	19	20	21	22	X 23	24							
9													
10	30	29	28	27	26	25							
11													
12	31	32	33	34	35	36							
13													

I, Kenneth L. Ross in a field survey on September 18, 2000, Do hereby certify that under requirements of P.A.74, Michigan P.A. of 1970, the corner points mentioned in lines 1 and 2 above were in conformance with regulations and rules therefore as required in the current manual of survey instructions of the United States Department of the Interior, Bureau of Land Management or by a decree of a Court of Law and/or that the corner points mentioned in lines 3, 4 and 5 above were in conformance with the rules of the Michigan Board of Land Surveyors or by a Decree of a Court of Law; established, re-established, monumented, re-monumented, recovered, found as expressed below:

¼ corner common to sections 22 and 23 of T17N, R17W

A. Description of original monument and accessories and/or subsequent restoration:

- GLO Hodgson 1836
Set qr. sec. post
20' Beech N31W 4 lks. (2.64') #1
18" Beech S36E 27 lks. (24.42') #2
- Towns 1911, B4 P30
"located this by old stakes and planted stone." No witnesses given.
- Stephens RLS 7318, 1968 unrecorded
Set 1" Sq. iron on E-W fence line
Fence cor. due West 23.49' #3
Tel. pole S18E 80.92' #4
White birch S12W 88.74' #5
- Ross RLS 17634
1973 unrecorded survey s
No references or witnesses
- Ross RLS 17634
Unrecorded survey 1980 & 1987
Fd. sq. iron rod, replaced w/ ½" I.R.
Clp. 6" maples S20E 40.59' #6
3" cherry N35E 35.91' #7
8" spruce N35E 38.7' #8


B. Description of corner evidence found and/or method applied in restoring or reestablishing corner:

I found 2 ea. ½" iron rods 0.10' apart I accepted the iron rod with a cap RLS 17634 (Ross). Corner is in the center of a N-S road.
The condition of the accessories is as follows: 1, 2, 3, and 4 are gone #5 is in good condition, 6, 7, and 8 are gone.
I found no evidence to dispute the location of this corner.

C. Description of monument for corner and accessories established to perpetuate locating the position of the corner:

- I replaced the Ross iron with a Harrison Monument stamped "Mason County Monument RLS 17634", I accepted this as a careful and faithful reestablishment of the position of the original corner.
- Ex. ½" iron (Pope 39093) East 33.01' #9
- P. pole S25E 123.63' (set 60d spike W. side) #10
- P. pole N19E 201.66' (set 60d spike W. side) #11
- 14" W. Birch S12W 88.60' (set 60d spike over ex. 60d spike on W. side) #12

Signed by [Signature] Date 10-09-2000
Surveyor's Michigan License No. 17634

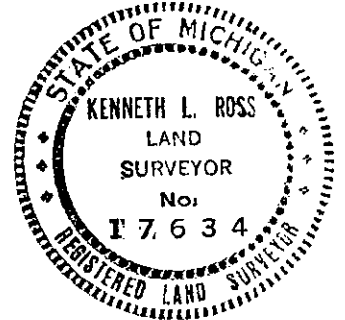

Approved by Peer Review Group on 10-05-2000
Kenneth L. Ross, County Representative [Signature]

FORM APPROVED BY MICHIGAN STATE BOARD OF LAND SURVEYORS, JAN. 28,

1971
REVISED MAY 14, 1976
REVISED JAN., 1983
ADAPTED FOR WORD PROCESSING MARCH, 1993