

**SURVEY &  
REMONUMENTATION**

**JAN 23 2001**

**LAND CORNER RECORDATION CERTIFICATE**

Filing Requirement of Act 74, Mich. P.A. 1970

**SECTION**

For corners In: Located In: Corner Code #  
Mason County

- 1. Public Land Survey T 17N R 17W M-8 ✓  
T 17N R 16W A-B
- 2. Property Controlling S T R  
in Section S T R
- 3. Miscellaneous S T R  
Property in Sec. S T R
- 4. Lot No. \_\_\_\_\_ Recorded Plat \_\_\_\_\_
- 5. Private Claims \_\_\_\_\_

FILED

AT 9:39 O'CLOCK A. M

AUG 1 2000

MARGARET KOLASKI ELLIOTT  
MASON COUNTY  
REGISTER OF DEEDS

**Register of Deeds Stamp & File Number**

	A	B	C	D	E	F	G	H	I	J	K	L	M
1													
2	6	5	4	3	2	1							
3													
4	7	8	9	10	11	12							
5													
6	18	17	16	15	14	13							
7													
8	X 19	20	21	22	23	24	X						
9													
10	30	29	28	27	26	25							
11													
12	31	32	33	34	35	36							
13													

I, Kenneth L. Ross, in a field survey on May 4, 2000, Do hereby certify that under requirements of P.A. 74, Michigan P.A. of 1970, the corner points mentioned in lines 1 and 2 above were in conformance with regulations and rules therefore as required in the current manual of survey instructions of the United States Department of the Interior, Bureau of Land Management or by a decree of a Court of Law and/or that the corner points mentioned in lines 3, 4 and 5 above were in conformance with the rules of the Michigan Board of Land Surveyors or by a Decree of a Court of Law; established, re-established, monumented, re-monumented, recovered, found as expressed below:

¼ corner common to sections 19 of T.17N, R.16W. and section 24 of T.17N., R17W.

**A. Description of original monument and accessories and/or subsequent restoration:**

- GLO 1837 Mullett & Brookfield set post. Towns in sec. survey June 1903. "located this stake and planted stone with cross." No witnesses given.
- Lynn 14 N72W 35 (23.10') #1
- Beech 16 S58W 17 (11.22') #2
- Stephens RLS 7318 1957 unrecorded survey "Ex. 1 1/4" pipe." (No witnesses) MCRC (undated) Stephens RLS 7318 for Consumers Power 1968
- PP NW 47.0' #3 Found 1 1/2" pipe
- F. Corner West 31.6' #4 TP S15E 156.18' #9
- PP NE 62.3' #5 PP Due West 31.88' #7
- Ross PLS 17634 Used corner on unrecorded survey, no description of corner. Iron pipe East 33.0' & On E-W fence 1' W. of CL
- 1.5' South #6 PP N88E 69.44' #8

**B. Description of corner evidence found and/or method applied in restoring or reestablishing corner:**


I found a 1 1/2" pipe in an existing monument box 2 ft. west of the centerline of a N-S road.  
Condition of witnesses: 1,2,3,5,6 and 9 are gone. 4, 7 and 8 are in good condition.  
I found nothing to dispute the location of this corner

**C. Description of monument for corner and accessories established to perpetuate locating the position of the corner:**

I left the 1 1/2" pipe in the monument box intact and accepted this as a careful and faithful reestablishment of the position of the original corner. I did not add additional monument.

- Ex. PK in S. side of PP N87W 31.57' #7
- Ex. 60d spike in n. side PP N89E 69.43' #8
- Center of 12" spruce N32E 140.7' (no nail)
- NE corner of metal building N50W 83.75'

Signed by [Signature] Date 8-10-2000  
Surveyor's Michigan License No. 17634

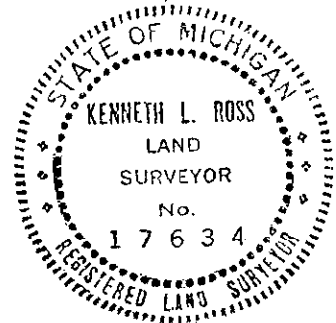

Approved by Peer Review Group on 8-10-2000  
Kenneth L. Ross, County Representative [Signature]

FORM APPROVED BY MICHIGAN STATE BOARD OF LAND SURVEYORS, JAN. 28, 1971  
REVISED MAY 14, 1975  
REVISED JAN, 1983  
ADAPTED FOR WORD PROCESSING MARCH, 1993