

SURVEY & REMONUMENTATION

JAN 23 2001

LAND CORNER RECORDATION CERTIFICATE

SECTION _____

Filing Requirement of Act 74, Mich. P.A. 1970

For corners In: Located In: Corner Code #

Mason County

Public Land Survey

T 17N R 17W

M-12 ✓

T 17N R 16W

A-12

T _____ R _____

T _____ R _____

Property Controlling in Section

S _____ T _____ R _____

Miscellaneous

S _____ T _____ R _____

Property in Sec.

S _____ T _____ R _____

Lot No. _____, Recorded Plat _____

Private Claims _____

FILED

AT 9:41 O'CLOCK A. M

AUG 17 2000

MARGARET KOLASKI ELLIOTT
MASON COUNTY
REGISTER OF DEEDS

Register of Deeds Stamp & File Number

Kenneth L. Ross, in a field survey on May 5, 2000, Do hereby certify that under requirements of Act 74, Michigan P.A. of 1970, the corner points mentioned in lines 1 and 2 above were in conformance with regulations and rules therefore as required in the current manual of survey instructions of the United States Department of the Interior, Bureau of Land Management or by a decree of a Court of Law and/or that the corner points mentioned in lines 3, 4 and 5 above were in conformance with the rules of the Michigan Board of Land Surveyors or by a Decree of a Court of Law; established, re-established, monumented, re-monumented, recovered, found as expressed below:

Corner common to section 31 of T.17N., R.16W. and section 36 of T.17N., R.17W.

Description of original monument and accessories and/or subsequent restoration:

Fullert & Brookfield set post
Cedar 5 N76W 10 (6.60') #1
Cedar 6 S57W 37 (24.42') #2

Loss L431, P293
1/2" rebar
No witness given

Description of corner evidence found and/or method applied in restoring or reestablishing corner:

found a 1 1/2" pipe with a 5/8" iron rod driven into the center inside an existing monument box. Corner is in center of N-S road and 4' south of centerline of road to the East.

Condition of witnesses: 1 and 2 are gone.

found nothing to dispute the location of this corner.

Description of monument for corner and accessories established to perpetuate locating the position of the corner:

left the 1 1/2" pipe and 1/2" iron rod in the monument box intact and accepted this as a careful and faithful reestablishment of the position of the original corner.

tie corner fence post S55E 43.95' ex. 60d spike on south side

tie S65W 37.48' Ex. 60d spike on south side.

distance North to M-11=2651.38'


distance South to M-13 = 2616.30'

	A	B	C	D	E	F	G	H	I	J	K	L	M
2	6	5	4	3	2	1							
3													
4	7	8	9	10	11	12							
5													
6	18	17	16	15	14	13							
7													
8	19	20	21	22	23	24							
9													
10	30	29	28	27	26	25							
11													
12	31	32	33	34	35	36							
13													

Signed by [Signature] Date 8-10-2000


Approved by Peer Review Group on 8-10-2000
Kenneth L. Ross, County Representative [Signature]

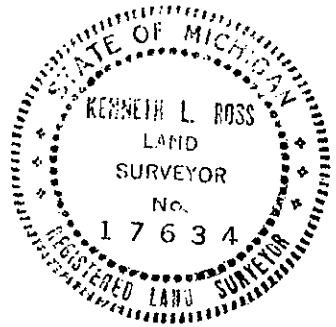

FORM APPROVED BY MICHIGAN STATE BOARD OF LAND SURVEYORS, JAN. 28, 1971
REVISED MAY 14, 1976
REVISED JAN., 1983
ADAPTED FOR WORD PROCESSING MARCH, 1993