

**SURVEY &  
REMONUMENTATION**

**JAN 23 2001**


**SECTION**

**LAND CORNER RECORDATION CERTIFICATE**

Filing Requirement of Act 74, Mich. P.A. 1970

For corners In: Located In: Corner Code #  
Mason County

- |                                    |             |       |
|------------------------------------|-------------|-------|
| 1. Public Land Survey              | T 17N R 16W | A13   |
|                                    | T 17N R 17W | M13 ✓ |
|                                    | T R         |       |
|                                    | T R         |       |
| 2. Property Controlling in Section | S T R       |       |
|                                    | S T R       |       |
| 3. Miscellaneous Property in Sec.  | S T R       |       |
|                                    | S T R       |       |

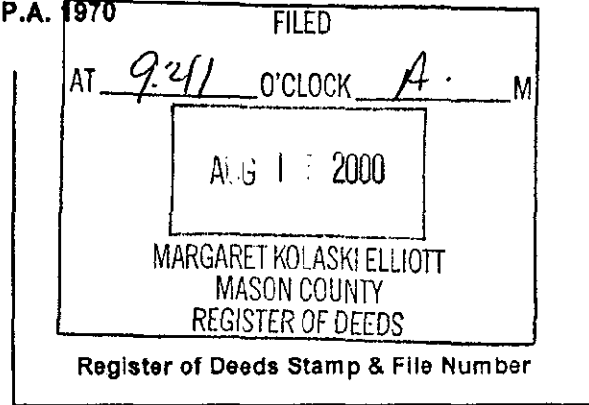

4. Lot No. \_\_\_\_\_, Recorded Plat \_\_\_\_\_  
5. Private Claims \_\_\_\_\_

I, Kenneth L. Ross in a field survey on May 5, 2000, Do hereby certify that under requirements of P.A. 74, Michigan P.A. of 1970, the corner points mentioned in lines 1 and 2 above were in conformance with regulations and rules therefore as required in the current manual of survey instructions of the United States Department of the Interior, Bureau of Land Management or by a decree of a Court of Law and/or that the corner points mentioned in lines 3, 4 and 5 above were in conformance with the rules of the Michigan Board of Land Surveyors or by a Decree of a Court of Law; established, re-established, monumented, re-monumented, recovered, found as expressed below:

Section corner common to section 31 of T17N., R16W., and section 36 of T.17N., R17W.

**A. Description of original monument and accessories and/or subsequent restoration:**

GLO 1938 Mullett & Brookfield set post  
Beech 16 N15W 16 lks (10.56') #1  
Beech 17 S53E 17 lks (11.22') #2

This corner was intended by GLO to be a common Township corner. However a corner was set by Patrick Salsbury while doing a survey in Oceana County that is 84.02 ft. west of the corner to be used as the controlling corner in Mason County. The drawing in the dossier dated 11-2-77 shows the position of the corners and their recommended use by Surveyors, Barnett 16923, Evans 22431, Lewandoski 7867 and Ross 17634.

R.O. Towns used this corner as a starting point to run a plan-profile of Scottville road to the North from this corner position.

**B. Description of corner evidence found and/or method applied in restoring or reestablishing corner:**

Found ex. 1/2" ir. on the PI of a curve on Scottville Road and Washington Road in Mason County. I found no evidence to dispute the location of this corner.

The condition of the accessories is as follows: 1 and 2 are gone

I found nothing to dispute the location of this corner.


**C. Description of monument for corner and accessories established to perpetuate locating the position of the corner:**

I replaced a 1/2" x 24" ir with 3" x 18 1/2" Harrison cast iron monument stamped "Mason County, Monument. I accepted this a careful and faithful reestablishment of the position of the original corner.

PP S10W 44.98' Set Mag nail on West side  
PP N07W 254.30' ex. PK on West side  
5' high metal post N41E 116.11'

Distance North to M-12 =2616.30'  
Distance West to M-1 of T16N, R17W is 84.02'

Signed by [Signature] Date 8-10-2000  
Surveyor's Michigan License No. 17634

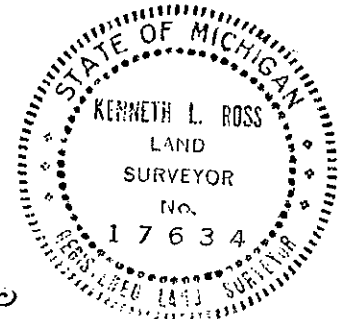

FORM APPROVED BY MICHIGAN STATE BOARD OF LAND SURVEYORS, JAN. 28,

1971  
REVISED MAY 14, 1978  
REVISED JAN. 1983  
ADAPTED FOR WORD PROCESSING MARCH, 1983

Approved by Peer Review Group on 8-10-2000  
Kenneth L. Ross, County Representative [Signature]