

SURVEY & REMONUMENTATION

JAN 23 2001

LAND CORNER RECORDATION CERTIFICATE

Filing Requirement of Act 74, Mich. P.A. 1970

SECTION

For corners In: _____ Located In: _____ Corner Code # _____
Mason County

- | | | | |
|------------------------------------|-------------------------|-------|-------|
| 1. Public Land Survey | T 17N R 18W | I-5 | |
| | T _____ R _____ | _____ | _____ |
| | T _____ R _____ | _____ | _____ |
| | T _____ R _____ | _____ | _____ |
| 2. Property Controlling in Section | S _____ T _____ R _____ | _____ | _____ |
| | S _____ T _____ R _____ | _____ | _____ |
| 3. Miscellaneous Property in Sec. | S _____ T _____ R _____ | _____ | _____ |
| | S _____ T _____ R _____ | _____ | _____ |

4. Lot No. _____, Recorded Plat _____
5. Private Claims _____

FILED

AT 4:12 O'CLOCK P. M

U-1 9 2000

MARGARET KOLASKI ELLIOTT
MASON COUNTY
REGISTER OF DEEDS

Register of Deeds Stamp & File Number

I, Kenneth L. Ross in a field survey on September 21, 2000, Do hereby certify that under requirements of P.A.74, Michigan P.A. of 1970, the corner points mentioned in lines 1 and 2 above were in conformance with regulations and rules therefore as required in the current manual of survey instructions of the United States Department of the Interior, Bureau of Land Management or by a decree of a Court of Law and/or that the corner points mentioned in lines 3, 4 and 5 above were in conformance with the rules of the Michigan Board of Land Surveyors or by a Decree of a Court of Law; established, re-established, monumented, re-monumented, recovered, found as expressed below:

Section corner common to sections 10, 11, 14 and 15 of T17N, R18W

A. Description of original monument and accessories and/or subsequent restoration:

GLO Hodgson 1838
Set post
Beech 8" S55W 33 lks. (21.78') #1
Beech 6" N9W 25 lks. (16.50') #2

Ross RLS 17634 LCRC
June 1978 L2, P53
Concrete monument w/cap RLS 17634
Centerline of rd. E. 22.3' #6
36" catalpa S50E 157.44' #9
6" maple N53E 55.97' #10
8" spruce N10E 104.46 #11
Drive to Dow Well to East

Floharty RLS LCRC L2, P5
July 1977
PK nail W/red paint at cen. rd. N37E 29.98' #15
PK nail w/red paint at cen. rd. S58E 30.00' #16
4" maple N58E 56.02 #8

Floharty RLS 18223 LCRC
September, 1975 L1, P277
Fd. conc. mon. in ditch on extended centerline of Lakeshore Rd. from North.
3" white birch cluster S11W 51.87' #3
8" pine N38W 38.00 #4
6" spruce N50E 61.54 #5
22' +/- W. of centerline Lakeshore Rd.

Floharty RLS 18223 LCRC L3, P16 & recorded survey 11-10-88 L374, P871
Fd. conc. mon.
8" maple N60E 55.63' #12
Center 3" pipe S75E 71.83' #13
2" Birch clump S10E 35.88' #14

Ross RLS 17634
Unrecorded surveys 1988, 1989, 1998 & 1998
Concrete monument

Consumers Power Co. 1974
37" Maple SE 61.68' #6
Pipe line marker SE 65.30' #7
T.P. West 15.15' #8

Mason County Rd. Commission. (undated)
"Iron in concrete W. side of rd."
Same as Consumers Power Co. 1974

B. Description of corner evidence found and/or method applied in restoring or reestablishing corner:

I found a 4" x 36" concrete monument in West ditch of road.


The Condition of the accessories is as follows: 1-5 are gone and 7-16 are gone. #6 is good. Note: Pipeline construction has destroyed all witnesses.

I find no reason to dispute the location of this corner.

C. Description of monument for corner and accessories established to perpetuate locating the position of the corner:

I replaced the 4" x 36" concrete monument with a Harrison Monument stamped "Mason County Monument, RLS 17634". I accepted this as a careful and faithful reestablishment of the position of the original corner.

Top center of 4 1/2" X 4.5" steel pipe S60E 74.17' #17
7" Maple N31E 77.71' (set 60d nail on E. side) #18
14" spruce N20E 104.99' (set 60d nail on E side) #19
P. pole N05 W 260.40' (set mag. nail on E. side) #20

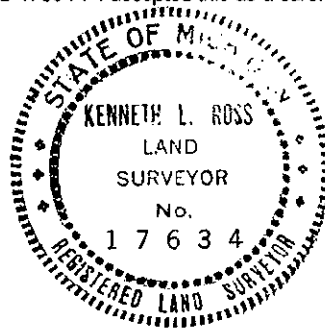

Signed by Kenneth L. Ross Date 10-09-2000
Surveyor's Michigan License No. 17634

Approved by Peer Review Group on 10-05-2000
Kenneth L. Ross, County Representative [Signature]

FORM APPROVED BY MICHIGAN STATE BOARD OF LAND SURVEYORS, JAN. 28, 1971
REVISED MAY 14, 1975
REVISED JAN., 1983
ADAPTED FOR WORD PROCESSING MARCH, 1983