

SURVEY & REMONUMENTATION

JAN 23 2001


LAND CORNER RECORDATION CERTIFICATE

SECTION

Filing Requirement of Act 74, Mich. P.A. 1970

For corners In: Located In: Corner Code #
Mason County

- | | | | |
|------------------------------------|-------------------------|-----|--|
| 1. Public Land Survey | T 17N R 18W | J-7 | |
| | T _____ R _____ | | |
| | T _____ R _____ | | |
| | T _____ R _____ | | |
| 2. Property Controlling in Section | S _____ T _____ R _____ | | |
| | S _____ T _____ R _____ | | |
| 3. Miscellaneous Property in Sec. | S _____ T _____ R _____ | | |
| | S _____ T _____ R _____ | | |
4. Lot No. _____, Recorded Plat _____
5. Private Claims _____

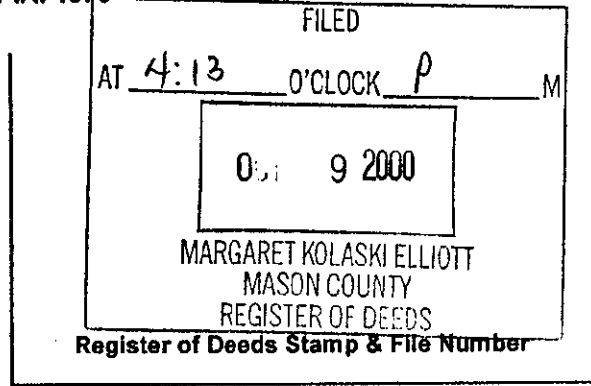

I, Kenneth L. Ross in a field survey on September 21, 2000, Do hereby certify that under requirements of P.A.74, Michigan P.A. of 1970, the corner points mentioned in lines 1 and 2 above were in conformance with regulations and rules therefore as required in the current manual of survey instructions of the United States Department of the Interior, Bureau of Land Management or by a decree of a Court of Law and/or that the corner points mentioned in lines 3, 4 and 5 above were in conformance with the rules of the Michigan Board of Land Surveyors or by a Decree of a Court of Law; established, re-established, monumented, re-monumented, recovered, found as expressed below:

¼ corner common to sections 14 and 23 of T17N, R18W

A. Description of original monument and accessories and/or subsequent restoration:

- | | | |
|---|--|---|
| GLO Hodgson 1838
9" Beech N12W 11 fks. (7.26') #1
8" Beech S13E 14 fks. (9.24') #2

Fluharty RLS 18223 LCRC L2, P5
July 1977
Fd. 1" pipe in mon. box
24" tree cluster N44E 45.59' #3
18" pine S07W 28.77' #4
12" pine S29W 29.85' #5 | Richard Kraft RLS 10064
Used J-7 on the recorded plats of
Sky View Estates L4 P36, 1973
Sky View Estates No. 2 L4 P37, 1973
Sky View Estates No. 3 L4 P38, 1973
No witnesses or references to corner

Ross RLS 17634, 1974
Used J-7 on the recorded plat of
Evergreen Acres Subdivision L4, P48
No witnesses or references to corner | Mason County Road Commission
Borsfay 1975
"Fd. ¾" pipe on surface, set mon. box
wit. O.K." |
|---|--|---|

B. Description of corner evidence found and/or method applied in restoring or reestablishing corner:

I found a 1" pipe in a monument box 1.3' South of the c/l of an E-W road.
 Condition of the accessories are as follows: 1 through 5 are gone.
 I found nothing to dispute the location of this corner.


C. Description of monument for corner and accessories established to perpetuate locating the position of the corner:

I accepted the 1" pipe in the monument box as a substantial and substantial monument for the corner and added no new monumentation. I accepted this as a careful and faithful reestablishment of the position of the original corner.

P. pole S82W 172.13 (set mag nail in N. side) #6
 P. pole N82E 110.96 (set mag. nail in S. side) #7
 P. pole S74E 129.10 (set mag. nail in N. side) #8
 Concrete monument N02E 40.07' #9

	A	B	C	D	E	F	G	H	I	J	K	L	M
1													
2	6	5	4	3	2	1							
3													
4	7	8	9	10	11	12							
5													
6	18	17	16	15	14	13							
7					X								
8	19	20	21	22	23	24							
9													
10	30	29	28	27	26	25							
11													
12	31	32	33	34	35	36							
13													

Signed by *Kenneth L. Ross* Date 10-09-2000
 Surveyor's Michigan License No. 17634

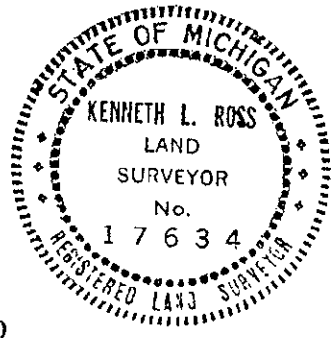

Approved by Peer Review Group on 10-05-2000
 Kenneth L. Ross, County Representative *[Signature]*

FORM APPROVED BY MICHIGAN STATE BOARD OF LAND SURVEYORS, JAN. 28,
 1971
 REVISED MAY 14, 1978
 REVISED JAN, 1983
 ADAPTED FOR WORD PROCESSING MARCH, 1993