

JAN 23 2001

SECTION

LAND CORNER RECORDATION CERTIFICATE

Filing Requirement of Act 74, Mich. P.A. 1970

For corners In: Located In: Corner Code #
Mason County

1. Public Land Survey	T 17N R 18W	K-1
	T R	
	T R	
	T R	
2. Property Controlling in Section	S T R	
	S T R	
3. Miscellaneous Property in Sec.	S T R	
	S T R	

FILED
AT 9:43 O'CLOCK A M
AUG 17 2000
MARGARET KOLASKI ELLIOTT
MASON COUNTY
REGISTER OF DEEDS
Register of Deeds Stamp & File Number

4. Lot No. _____ Recorded Plat _____
5. Private Claims _____

	A	B	C	D	E	F	G	H	I	J	K	L	M
1													
2	6	5	4	3	2	1							
3													
4	7	8	9	10	11	12							
5													
6	18	17	16	15	14	13							
7													
8	19	20	21	22	23	24							
9													
10	30	29	28	27	26	25							
11													
12	31	32	33	34	35	36							
13													

I, Kenneth L. Ross in a field survey on July 20, 2000, Do hereby certify that under requirements of P.A.74, Michigan P.A. of 1970, the corner points mentioned in lines 1 and 2 above were in conformance with regulations and rules therefore as required in the current manual of survey instructions of the United States Department of the Interior, Bureau of Land Management or by a decree of a Court of Law and/or that the corner points mentioned in lines 3, 4 and 5 above were in conformance with the rules of the Michigan Board of Land Surveyors or by a Decree of a Court of Law; established, re-established, monumented, re-monumented, recovered, found as expressed below:

Section corner common to section 1 and 2 of T17N, R18W.

A. Description of original monument and accessories and/or subsequent restoration:

Mullett & Brookfield 1837 Set post
10" pine S19E 30 lks. (19.80') #1
12" Beech S66W 33 lks. (21.78') #2

Ross PLS 17634 1972 LCRC L1 P30
Found iron 26.48' East of SE
Cor. sec. 35 T18N, R18W
PP N28E 52.1' #7
Street sign S49E 50.3' #8
Cedar clump N28W 61.8' #9

Jack F. Erickson PLS 16929
LCRC Oct. 1988 L2 P291
Placed Boat spike in mon. box
PP S28E 171.27' #14
Guy pole N58W 83.28' #15
Middle west end so South Conc. rail S82E 276.66' #16
Middle West end of North Conc. rail N87E 287.51' #17

WCRC 1964
1/4" pipe
TP NW 56.13' #3
PP NE 70.71' #4
TP SE 56.53' #5
Stop sign SW 43.73' #6

Douglas W. Hooth RLS
LCRC L1 P320 1977
1" iron pipe in mon. box
PP w/spike N35E 49.84' #10
13" w. pine w/ spike N45W 78.35' #11
G. pole N60W 67.10' #12
PP S30E 78.78' #13

3. Description of corner evidence found and/or method applied in restoring or reestablishing corner:

found a boat spike in a monument box in the center of and E-W road, cen. rd. to N is 16.5' West, cen. of rd. to S is West 16.5'. Section corner for corner common to sections 35 and 36 of T18N, R18W. is west 26.53'.

The condition of the accessories are as follows: 1,2,3,4,5,6,7,8,9,10,12, and 13 are gone.


1,14,15,16 and 17 are in good condition.

found nothing to dispute the location of this corner.

2. Description of monument for corner and accessories established to perpetuate locating the position of the corner:

replaced the boat spike with a 5/8" X 18" iron rod w/aluminum cap in a monument box, stamped "Mason County Monument PLS 17634". I accepted this as a careful and faithful reestablishment of the position of the original corner.

Most Westerly guard rail post on N. side rd. N78E 124.54' (set 60d spike S side)
Lower Pole S30E 62.98' (set 60d spike W side)
Lower pole S35E 171.41' (ex. MSHD shiner & 16d nail on N side) #14
Lower pole N55W 83.20' (ex. MSHD shiner & 16d nail on N side) #15
C-13 of T18N, R18W is West 26.53'

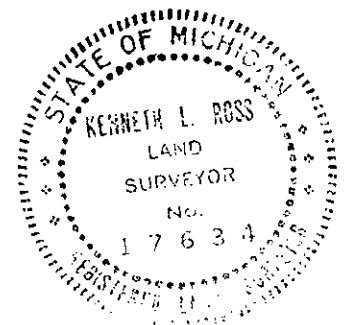

Signed by [Signature] Date 8-10-2000
Surveyor's Michigan License No. 17634

Approved by Peer Review Group on 8-10-2000
Kenneth L. Ross, County Representative [Signature]

FORM APPROVED BY MICHIGAN STATE BOARD OF LAND SURVEYORS, JAN. 28,

1971
REVISED MAY 14, 1978
REVISED JAN., 1983
ADAPTED FOR WORD PROCESSING MARCH, 1993