


MAR 08 1994

COMMISSION

LAND CORNER RECORDATION CERTIFICATE
Filing Requirement of Act 74, Mich. P.A. 1970

For corners in

Mason (County)	Located In:	Corner Code #
1. Public Land Survey	T 17N R 18W	K-7
	T _____ R _____	_____
	T _____ R _____	_____
	T _____ R _____	_____
2. Property Controlling in Section	S _____ T _____ R _____	_____
	S _____ T _____ R _____	_____
3. Miscellaneous Property in Sec.	S _____ T _____ R _____	_____
	S _____ T _____ R _____	_____

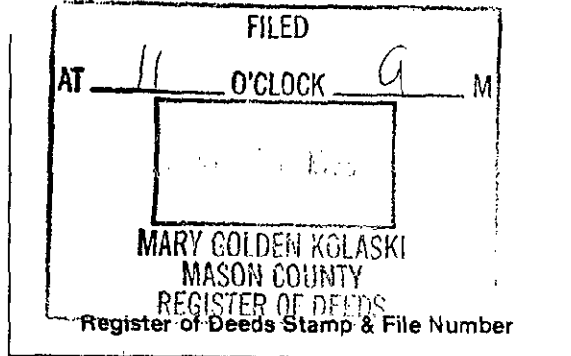

4. Lot No. _____, Recorded Plat _____
5. Private Claims _____

I, Richard Hays, in a field survey on November 2, 1993, do hereby certify that under requirements of P.A. 74, Michigan P.A. of 1970, the corner points mentioned in lines 1 and 2 above were in conformance with regulations and rules therefore as required in the current manual of survey instructions of the United States Department of the Interior, Bureau of Land Management or by a decree of a Court of Law and/or that the corner points mentioned in lines 3, 4 and 5 above were in conformance with the rules of the Michigan Board of Land Surveyors or by a Decree of a Court of Law; established, re-established, monumented, re-monumented, recovered, found as expressed below:

	A	B	C	D	E	F	G	H	I	J	K	L	M
2	8		5		4		3		2		1		
3													
4	7		8		9		10		11		12		
5													
6	15		17		16		15		14		13		
7													
8	19		20		21		22		23		24		
9													
10	30		29		28		27		26		25		
11													
12	31		32		33		34		35		36		
13													

NOTE: Not more than 4 corners, all in the same town and range, may be recorded on this certificate.

A. Description of original monument and accessories and/or subsequent restoration:

K-7 SECTION CORNER COMMON TO SECTIONS 13,14,23 & 24

1838:G.L.O. Set Post 1967:K. Stephens Survey 1988:H. Fluharty
8" Beech N-35°-W 11 Links for Consumers Power Found 1/2" Bar in Mon.
8" Beech S-26°-E 44 Links Found Corner Box 4' South of
Centerline of Road.
1881:C.E. Mitchell Survey 1976:Mason Co. Rd Comm. Benchmark-Conc. Mon.
Identified Corner Stone 2" Spruce S-20°-E 25.05' with Metal Cap(G.P.S.
& Govt Markers 2" Spruce S-45°-W 13.71' Summit 2) S-72°-W
8" Cherry N-82°-E 62.98' 179.08' (L.C.R.C. Liber 3, Pg 23)

B. Description of corner evidence found and/or method applied in restoring or reestablishing corner:


K-7 SECTION CORNER COMMON TO SECTIONS 13,14,23 & 24

1993:Found 1/2" Bar in Monument Box and Witnesses(L.C.R.C. Liber 3, Page 23.)
West End of R/W Fence (South Side of Road) South 49.70'
West End of R/W Fence (North Side of Road) N-04°-E 49.79'
Bench Mark-Conc. Mon. with Metal Cap(G.P.S. Summit 2) S-72°-W 179.08'

C. Description of monument for corner and accessories established to perpetuate locating the position of the corner:

K-7 SECTION CORNER COMMON TO SECTIONS 13,14,23 & 24

Placed Mason County Monument on 1/2" Bar with Cap stamped to identify Corner. This Monument is accepted as the best available evidence of the position of the Original Corner.
4" W. Cherry N-24°-E 67.10'
West end of Corner Guard Rail Post S-74°-E 156.88'
B.M.-Conc. Mon. w/Metal Cap (G.P.S. Summit 2) S-72°-W 179.08'
4' South of Centerline of Road
West End of R/W Fence (South Side of Road) South 49.70'
West End of R/W Fence (North Side of Road) N-04°-E 49.79'

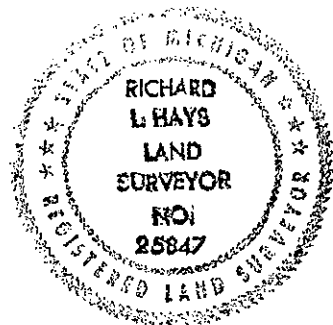

Signed by Richard Hays Date November 8, 1993
Surveyor's Michigan License No. 25847 Peer Group Reviewed and Approved
Date: 11-1-93 Kenneth L. Ross, Mason County Surveyor