

**SURVEY &  
REMONUMENTATION**

MAR 08 1994

**COMMISSION**

**LAND CORNER RECORDATION CERTIFICATE**

Filing Requirement of Act 74, Mich. P.A. 1970


For corners in

Mason \_\_\_\_\_ Located In: \_\_\_\_\_ Corner Code ## \_\_\_\_\_  
(County)

1. Public Land Survey T 17N R 18W \_\_\_\_\_ K-9  
T \_\_\_\_\_ R \_\_\_\_\_  
T \_\_\_\_\_ R \_\_\_\_\_  
T \_\_\_\_\_ R \_\_\_\_\_

2. Property Controlling S \_\_\_\_\_ T \_\_\_\_\_ R \_\_\_\_\_  
in Section S \_\_\_\_\_ T \_\_\_\_\_ R \_\_\_\_\_

3. Miscellaneous S \_\_\_\_\_ T \_\_\_\_\_ R \_\_\_\_\_  
Property in Sec. S \_\_\_\_\_ T \_\_\_\_\_ R \_\_\_\_\_

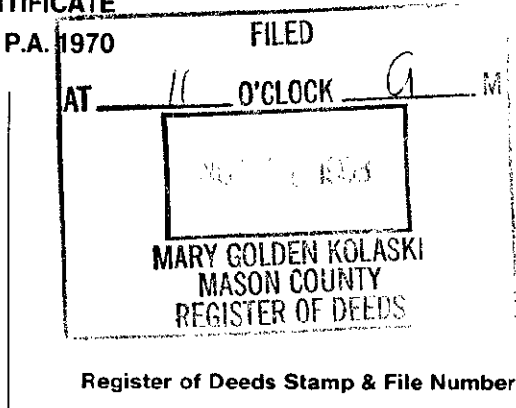

4. Lot No. \_\_\_\_\_, Recorded Plat \_\_\_\_\_  
5. Private Claims \_\_\_\_\_

|    |    |    |    |    |    |    |   |   |   |   |   |   |
|----|----|----|----|----|----|----|---|---|---|---|---|---|
| A  | B  | C  | D  | E  | F  | G  | H | I | J | K | L | M |
| 2  | 6  | 5  | 4  | 3  | 2  | 1  |   |   |   |   |   |   |
| 3  |    |    |    |    |    |    |   |   |   |   |   |   |
| 4  | 7  | 8  | 9  | 10 | 11 | 12 |   |   |   |   |   |   |
| 5  |    |    |    |    |    |    |   |   |   |   |   |   |
| 6  | 18 | 17 | 16 | 15 | 14 | 13 |   |   |   |   |   |   |
| 7  |    |    |    |    |    |    |   |   |   |   |   |   |
| 8  | 19 | 20 | 21 | 22 | 23 | 24 |   |   |   |   |   |   |
| 9  |    |    |    |    |    |    |   |   |   |   |   |   |
| 10 | 30 | 29 | 28 | 27 | 26 | 25 |   |   |   |   |   |   |
| 11 |    |    |    |    |    |    |   |   |   |   |   |   |
| 12 | 31 | 32 | 33 | 34 | 35 | 36 |   |   |   |   |   |   |
| 13 |    |    |    |    |    |    |   |   |   |   |   |   |

I, Richard Hays, in a field survey on October 29, 1993, do hereby certify that under requirements of P.A. 74, Michigan P.A. of 1970, the corner points mentioned in lines 1 and 2 above were in conformance with regulations and rules therefore as required in the current manual of survey instructions of the United States Department of the Interior, Bureau of Land Management or by a decree of a Court of Law and/or that the corner points mentioned in lines 3, 4 and 5 above were in conformance with the rules of the Michigan Board of Land Surveyors or by a Decree of a Court of Law; established, re-established, monumented, re-monumented, recovered, found as expressed below:

**NOTE: Not more than 4 corners, all in the same town and range, may be recorded on this certificate.**

A. Description of original monument and accessories and/or subsequent restoration:

**K-9 Section CORNER COMMON TO SECTIONS 23,24,25, & 26**  
 1838:G.L.O. Set Post 1977:H. Fluharty Found 3/4" Iron Pipe  
 18" Cedar S-56°-E 17 Links (L.C.R.C. Liber 2, Pg 4, Liber 2, Pg 76.)  
 11" Hemlock N-51°-W 13 Links Act 132, Liber 1, Pg 465)  
 8" Cedar N-49°-W 14.80'  
 1881:C.E. Mitchell Survey 8" Cedar S-83°-W 9.36'  
 Witnesses Trees standing 9" Hemlock N-54°-E 13.10'

1967:K. Stephens Survey for Consumers Power-Set Corners

B. Description of corner evidence found and/or method applied in restoring or reestablishing corner:

**K-9 Section CORNER COMMON TO SECTIONS 23,24,25, & 26**  
 1993:Found 3/4" Iron Pipe and Witnesses (L.C.R.C. Liber 2, Page 76)  
 8" Cedar N-49°-W 14.80'  
 9" Cedar S-83°-W 9.36'  
 9" Hemlock(Dead) N-54°-E 13.10'

C. Description of monument for corner and accessories established to perpetuate locating the position of the corner:

**K-9 Section CORNER COMMON TO SECTIONS 23,24,25, & 26**  
 Replaced Found 3/4" Iron Pipe with Mason County Monument with 5/8" Re-Rod with cap stamped to identify Corner. This Monument is accepted as the best available evidence of the position of the Original Corner.  
 6" Cedar S-17°-E 17.81'  
 8" Cedar S-68°-E 6.54'  
 8" Cedar S-73°-W 10.41'  
 8" Cedar N-50°-W 14.81'  
 Cedar Post Northwest 0.70'



Signed by Richard Hays Date November 8, 1993  
 Surveyor's Michigan License No. 25847 Peer Group Reviewed and Approved

**LIBER 3 PAGE 160**

Date: 1-9-93  
 Kenneth L. Ruff  
 Mason County Surveyor