

**SURVEY & REMONUMENTATION**

**JAN 23 2001**

**LAND CORNER RECORDATION CERTIFICATE**

Filing Requirement of Act 74, Mich. P.A. 1970

**SECTION**


For corners in:

Located in:

Corner Code #

Mason County

1. Public Land Survey	T	17N	R	18W	L-1
	T		R		
	T		R		
	T		R		
2. Property Controlling in Section	S		T	R	
	S		T	R	
3. Miscellaneous Property in Sec.	S		T	R	
	S		T	R	

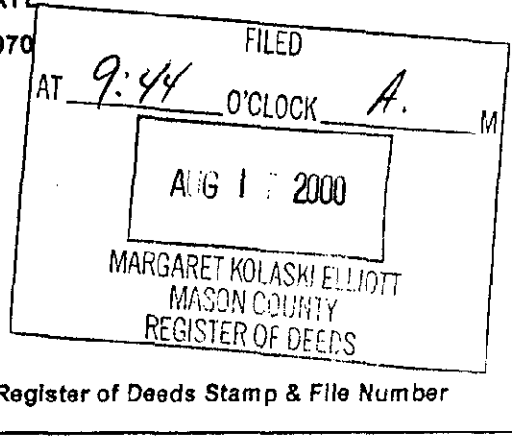

- 4. Lot No. \_\_\_\_\_, Recorded Plat \_\_\_\_\_
- 5. Private Claims \_\_\_\_\_

	A	B	C	D	E	F	G	H	I	J	K	L	M
1													
2	6		5		4		3		2		1		
3													
4	7		8		9		10		11		12		
5													
6	18		17		16		15		14		13		
7													
8	19		20		21		22		23		24		
9													
10	30		29		28		27		26		25		
11													
12	31		32		33		34		35		36		
13													

I, Kenneth L. Ross in a field survey on June 21, 2000, Do hereby certify that under requirements of P.A. 74, Michigan P.A. of 1970, the corner points mentioned in lines 1 and 2 above were in conformance with regulations and rules therefore as required in the current manual of survey instructions of the United States Department of the Interior, Bureau of Land Management or by a decree of a Court of Law and/or that the corner points mentioned in lines 3, 4 and 5 above were in conformance with the rules of the Michigan Board of Land Surveyors or by a Decree of a Court of Law; established, re-established, monumented, re-monumented, recovered, found as expressed below:

North Quarter corner for section 1 of T17N, R18W.

**A. Description of original monument and accessories and/or subsequent restoration:**

Nothing set on GLO survey.

- MCRC 1958 Douglas W. Hooth PLS 7966 Jan. 1977
- PP NW 142.8 #1 1" pipe
- W. stake 1" X 2" NW 30.0' #2 PP N15W 143.67' #7
- Face of large St. NW 31.8' #3 G. post N70W 57.65' #8
- W. stake 1" x 2" NE 50.0' #4 G. post S60W 36.23' #9
- G. post S20W 21.12' #10

- Richard H. Kraft PLS 10064 1972
- L. 1 P. 20
- 1" pipe
- 4" pine N35E 50.65' #5
- Road sign N50E 43.7' #6
- P.P. N10W 140.89' #7

**B. Description of corner evidence found and/or method applied in restoring or reestablishing corner:**

I found a 5/8" iron rod in a monument box in the centerline of E-W rd. and 10' East of the centerline of a road to the North.

The condition of the accessories are as follows: 1,2,3,4,5, and 6 are gone.


7 is good but witness distance by Kraft is incorrect, Hooth's distance is correct. 8, 9, and 10 are good but no witness nail are present.

I found nothing to dispute the location of this corner.

**C. Description of monument for corner and accessories established to perpetuate locating the position of the corner:**

I placed a 2 1/2" aluminum cap stamped "Mason County Monument PLS 17634" on the existing 5/8" iron rod in the monument box. I accepted this as a careful and faithful reestablishment of the position of the original corner.

- Street light pole S25W 22.59' (MSHD shiner & 16d nail in E. side)
- Power pole N 57E 59.04' (set PK nail in W. side)
- NW corner of House N40E 120.97'
- Most Easterly Guard rail post on N. side rd. N72W 58.00' (set 60d spike on S side) #8
- 1/4 corner for section 36 of T18N, R18W is West 13.72'

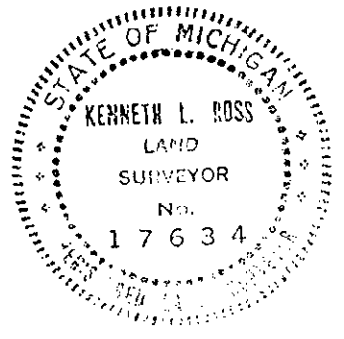

Signed by [Signature] Date 8-10-2000  
 Surveyor's Michigan License No. 17634

Approved by Peer Review Group on 8-10-2000  
 Kenneth L. Ross, County Representative [Signature]

FORM APPROVED BY MICHIGAN STATE BOARD OF LAND SURVEYORS, JAN. 26, 1971  
 REVISED MAY 14, 1976  
 REVISED JAN., 1983  
 ADAPTED FOR WORD PROCESSING MARCH, 1993