

SURVEY &
MONUMENTATION

MAR 08 1994

COMMISSION

LAND CORNER RECORDATION CERTIFICATE
Filing Requirement of Act 74, Mich. P.A. 1970

For corners in

Mason _____ Located In: _____ Corner Code # _____
(County)


1. Public Land Survey T 17N R 18W _____ L-7
T _____ R _____
T _____ R _____
T _____ R _____

2. Property Controlling S _____ T _____ R _____
in Section S _____ T _____ R _____

3. Miscellaneous S _____ T _____ R _____
Property in Sec. S _____ T _____ R _____

4. Lot No. _____, Recorded Plat _____

5. Private Claims _____

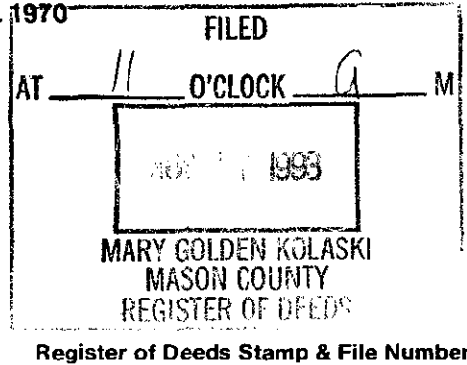

A	B	C	D	E	F	G	H	I	J	K	L	M
2	6	5	4	3	2	1						
3												
4	7	8	9	10	11	12						
5												
6	18	17	16	15	14	13						
7												
8	19	20	21	22	23	24						
9												
10	30	29	28	27	26	25						
11												
12	31	32	33	34	35	36						
13												

I, Richard Hays, in a field survey on October 28, 1993, do hereby certify that under requirements of P.A. 74, Michigan P.A. of 1970, the corner points mentioned in lines 1 and 2 above were in conformance with regulations and rules therefore as required in the current manual of survey instructions of the United States Department of the Interior, Bureau of Land Management or by a decree of a Court of Law and/or that the corner points mentioned in lines 3, 4 and 5 above were in conformance with the rules of the Michigan Board of Land Surveyors or by a Decree of a Court of Law; established, re-established, monumented, re-monumented, recovered, found as expressed below:

NOTE: Not more than 4 corners, all in the same town and range, may be recorded on this certificate.

A. Description of original monument and accessories and/or subsequent restoration:

L-7 1/4 CORNER COMMON TO SECTIONS 13 & 24

1838:G.L.O. Set Post 1967:K. Stephens Survey for 1988:H. Fluharty Found 3/4"
18" Beech N-06°-W 14 Links Consumers Power-Set Corner Iron in Mon. Box
18" Beech S-65°-E 45 Links halfway between the Section (L.C.R.C. Liber 3, Page 22)
Corners-No Witnesses. P. Pole S-78°-E 130.01'
P. Pole West 80.96'
P. Pole N-68°-W 131.53'

1881:C.E. Mitchell Survey
Fd Corner & Govt Witnesses 1976:Mason Co. Rd. Comm. 3/4" Iron Pipe in Mon Box
P.Pole S-82°-E 130.04'/P.Pole S-85°-E 80.89'/T.Pole N-75°-W 131.59'

B. Description of corner evidence found and/or method applied in restoring or reestablishing corner:

L-7 1/4 CORNER COMMON TO SECTIONS 13 & 24


1993:Found 3/4" Pipe in Monument Box (L.C.R.C. Liber 3, Page 22.)
Power Pole S-78°-E 130.01'
Power Pole West 80.96'
Power Pole N-68°-W 131.53'

C. Description of monument for corner and accessories established to perpetuate locating the position of the corner:

L-7 1/4 CORNER COMMON TO SECTIONS 13 & 24

Placed Mason County Monument with 5/8" Re-Rod with cap stamped to identify Corner inside 3/4" Iron Pipe. This Monument is accepted as the best available evidence of the position of the Original Corner.

Power Pole S-80°-E 130.01'
Power Pole S-89°-W 80.96'
Power Pole N-70°-W 131.60'
Face of Apple Tree in Orchard N-16°-E 58.05'
Monument Box is 10' South of the Center line of the Road on the edge of the blacktop.

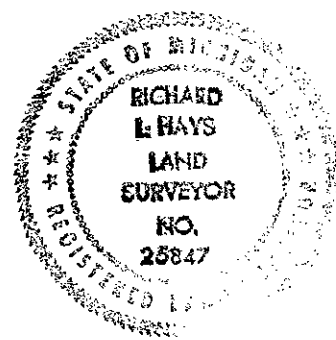

Signed by Richard Hays Date November 8, 1993
Peer Group Reviewed and Approved