

**SURVEY & REMONUMENTATION**

JAN 28 2001

**LAND CORNER RECORDATION CERTIFICATE**

**SECTION**

Filing Requirement of Act 74, Mich. P.A. 1970

For corners In: Located In: Corner Code #  
Mason County

- 1. Public Land Survey T 17N R 18W L-10 *Seg. 2*
- T R
- T R
- T R
- 2. Property Controlling in Section S T R
- S T R
- 3. Miscellaneous Property in Sec. S T R
- S T R

FILED

AT 4:14 O'CLOCK P. M

DEC 9 2000

MARGARET KOLASKI ELLIOTT  
MASON COUNTY  
REGISTER OF DEEDS

Register of Deeds Stamp & File Number

- 4. Lot No. \_\_\_\_\_ Recorded Plat \_\_\_\_\_
- 5. Private Claims \_\_\_\_\_

	A	B	C	D	E	F	G	H	I	J	K	L	M
1													
2	6	5	4	3	2	1							
3													
4	7	8	9	10	11	12							
5													
6	18	17	16	15	14	13							
7													
8	19	20	21	22	23	24							
9													
10	30	29	28	27	26	<del>X</del>							
11													
12	31	32	33	34	35	36							
13													

I, Kenneth L. Ross in a field survey on September 18, 2000, Do hereby certify that under requirements of P.A.74, Michigan P.A. of 1970, the corner points mentioned in lines 1 and 2 above were in conformance with regulations and rules therefore as required in the current manual of survey instructions of the United States Department of the Interior, Bureau of Land Management or by a decree of a Court of Law and/or that the corner points mentioned in lines 3, 4 and 5 above were in conformance with the rules of the Michigan Board of Land Surveyors or by a Decree of a Court of Law; established, re-established, monumented, re-monumented, recovered, found as expressed below:

Center 1/4 corner of section 25, T17N, R18W

**A. Description of original monument and accessories and/or subsequent restoration:**

This corner was not set by GLO  
 Ross RLS 17634  
 Unrecorded surveys, 1994, and 1995.  
 L 501 P 1758  
 Fd. 1/4" x 1.4' above ground SE cor.  
 Govt. Lot 1, AKA as Center 1/4 corner.  
 10" Hemlock S24W 18.79' #1  
 12" Hemlock S46E 35.97' #2  
 10" Hemlock S75W 44.24' #3  
 10" Ash N30W 32.61' #4  
 Fd. trace of fence north and fence that was down to the west

Ross RLS 17634  
 In October, 1998 pursuant to judgment on court order 97-95-CZ in conjunction with the amended plat I replaced the 1/4" x 1 1/2" pipe with a concrete monument.


**B. Description of corner evidence found and/or method applied in restoring or reestablishing corner:**

I found a concrete monument with a trace of fence North and East and visible remains of a fence to the West.  
 Condition of the accessories is as follows: 1, 2, 3, and 4 are good condition.  
 I found no reason to dispute the location of this corner.

**C. Description of monument for corner and accessories established to perpetuate locating the position of the corner:**

I replaced the concrete monument with a Harrison monument stamped "Mason County Monument PLS 17634". I accepted this as a careful and faithful establishment of the position of the corner.

10" Hemlock S24W 18.79' #1 ex. 60d nail  
 Hemlock S46E 35.97' #2 ex. 60d nail  
 10" Hemlock S75W 44.24' #3 ex. 60d nail  
 10" Ash N30W 32.61' #4 ex. 60d nail

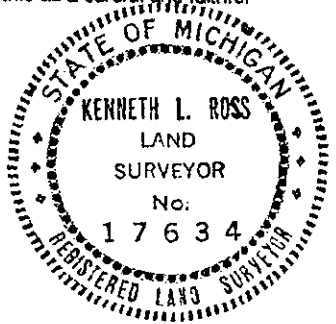

Signed by *Kenneth L. Ross* Date 10-09-2000  
 Surveyor's Michigan License No. 17634

Approved by Peer Review Group on 10-09-2000  
 Kenneth L. Ross, County Representative *[Signature]*

FORM APPROVED BY MICHIGAN STATE BOARD OF LAND SURVEYORS, JAN. 28, 1971  
 REVISED MAY 14, 1978  
 REVISED JAN., 1983  
 ADAPTED FOR WORD PROCESSING MARCH, 1993