

**SURVEY &  
REMONUMENTATION**

MAR 08 1994

**COMMISSION**

**LAND CORNER RECORDATION CERTIFICATE**  
Filing Requirement of Act 74, Mich. P.A. 1970

For corners in  
Mason  
(County)

Located In: \_\_\_\_\_ Corner Code # \_\_\_\_\_


1. Public Land Survey T 17N R 18W M-10 ✓  
T \_\_\_\_\_ R \_\_\_\_\_  
T \_\_\_\_\_ R \_\_\_\_\_  
T \_\_\_\_\_ R \_\_\_\_\_

2. Property Controlling S \_\_\_\_\_ T \_\_\_\_\_ R \_\_\_\_\_  
in Section S \_\_\_\_\_ T \_\_\_\_\_ R \_\_\_\_\_

3. Miscellaneous S \_\_\_\_\_ T \_\_\_\_\_ R \_\_\_\_\_  
Property in Sec. S \_\_\_\_\_ T \_\_\_\_\_ R \_\_\_\_\_

4. Lot No. \_\_\_\_\_, Recorded Plat \_\_\_\_\_

5. Private Claims \_\_\_\_\_

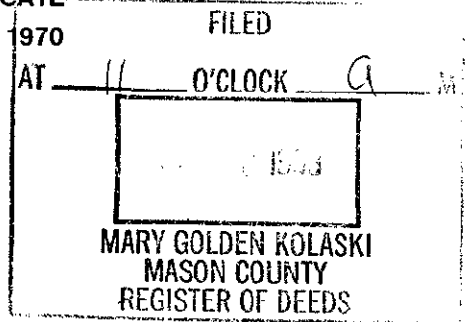

Register of Deeds Stamp & File Number

I, Richard Hays, in a field survey on October 29, 19 93, do hereby certify that under requirements of P.A. 74, Michigan P.A. of 1970, the corner points mentioned in lines 1 and 2 above were in conformance with regulations and rules therefore as required in the current manual of survey instructions of the United States Department of the Interior, Bureau of Land Management or by a decree of a Court of Law and/or that the corner points mentioned in lines 3, 4 and 5 above were in conformance with the rules of the Michigan Board of Land Surveyors or by a Decree of a Court of Law; established, re-established, monumented, re-monumented, recovered, found as expressed below:


**NOTE: Not more than 4 corners, all in the same town and range, may be recorded on this certificate.**

	A	B	C	D	E	F	G	H	I	J	K	L	M
2	6		5		4		3		2		1		
3													
4	7		8		9		10		11		12		
5													
6	18		17		16		15		14		13		
7													
8	19		20		21		22		23		24		
9													
10	30		29		28		27		26		25		
11													
12	31		32		33		34		35		36		
13													

A. Description of original monument and accessories and/or subsequent restoration:  
**M-10 1/4 CORNER COMMON TO SECTION 25, T17N-R18W & SECTION 30, T17N-R17W**  
 1838:G.L.O. Set Post 1988:H. Fluharty  
 16" W. Ash S-42°-W 41 Links Found Sq. Bolt in Monument Box 3.5'  
 6" Hemlock N-23°-W 14 Links West of the Center Line of US 31.  
 (L.C.R.C. Liber 3, Page 17.)  
 1982:M.D.O.T. Job # 09423-1/2" 10" Tw. Chinese Elm S-52°-W 47.07'  
 Iron in Monument Box 3.6' West of the Center line of US 31. Power Pole N-25°-W 54.67'  
 Power Pole N-30°-W 55.02' Power Pole N-47°-E 79.32'  
 Power Pole N-45°-E 79.45'

B. Description of corner evidence found and/or method applied in restoring or reestablishing corner:  
**M-10 1/4 CORNER COMMON TO SECTION 25, T17N-R18W & SECTION 30, T17N-R17W**  
 1993 Found Square Bolt in Monument box and Witnesses(L.C.R.C. Liber 3, Page 17.)  
 Tw. Chinese Elm S-50°-W 47.25'  
 Power Pole N-28°-W 54.62'  
 Power Pole N-45°-E 97.14'

C. Description of monument for corner and accessories established to perpetuate locating the position of the corner:  
**M-10 1/4 CORNER COMMON TO SECTION 25, T17N-R18W & SECTION 30, T17N-R17W**  
 Replaced Found Square Bolt with a Mason County Monument with 5/8" Re-Rod with cap stamped to identify Corner. This Monument is accepted as the best available evidence of the position of the Original Corner.  
 Tw. Chinese Elm S-50°-W 47.25'  
 Power Pole N-28°-W 54.62'  
 Power Pole N-45°-E 97.14'  
 Center Line of Old US-31 West 3.50'  
 U.S.G.S. Bench Mark Monument with Brass Cap J 26 1930 S-07°E 190.20'

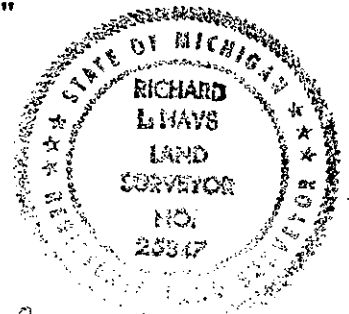

Signed by Richard Hays Date November 2 1993  
 Surveyor's Michigan License No. 25847 Date 11-2-93  
 Peer Group Reviewed and Approved  
 Kenneth L. ...  
 Mason County Surveyor

FORM APPROVED BY MICHIGAN STATE BOARD OF LAND SURVEYORS, JAN. 28, 1971  
 REVISED MAY 14, 1975  
 REVISED JAN., 1983

**LIBER 3 PAGE 159**