


STATE OF MICHIGAN
DEPARTMENT
OF
NATURAL RESOURCES

LAND CORNER RECORD

MASON COUNTY
T 18 N R 15 W

DESCRIPTION OF CORNER NW Corner of SW 1/4 of SE 1/4 Sec. 24
CORNER MONUMENT Set 1"x6" pipe & 6"x6" Flat top Cedar post
DATE MONUMENT PLACED AND WITNESSED 5-19-72
WITNESSES TO CORNER.....

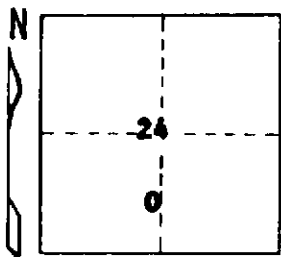

W. Pine 16" N 85 W 41.66'


W. Pine 9" S 65 W 79.70'

AND

CIRCLE CORNER REGISTERED

DESCRIPTION IN DETAIL AS TO HOW CORNER WAS LOCATED AND IDENTIFIED OR RESTORED.

Established corner per standard B.L.M. instructions.

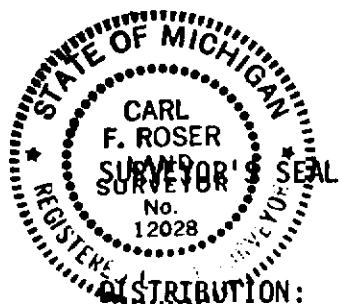

SIGNED

Carl F. Roser
REGISTERED LAND SURVEYOR
12028

DATE

5-26-72

Forestry Division, Lansing